

## Singerman, Joel

---

**From:** Eaton, Daniel J (DEC) <daniel.eaton@dec.ny.gov>  
**Sent:** Thursday, August 26, 2021 4:39 PM  
**To:** Tsiamis, Christos  
**Cc:** Garbarini, Doug; Singerman, Joel  
**Subject:** FW: Agenda in question and answer format  
**Attachments:** Citizens MGP\_Responses questions on the 2021-08-27 Meeting Agenda.docx; Drawing Attachments.2021-08-26.pdf; Citizens Hydraulic Relief System Design - Background and Timeline.docx

Christos,

I understand you are returning from vacation to join us. Here is a copy of the agenda for the meeting tomorrow.

Dan

---

**From:** Eaton, Daniel J (DEC)  
**Sent:** Thursday, August 26, 2021 4:02 PM  
**To:** Garbarini.Doug@epamail.epa.gov; Singerman, Joel <Singerman.Joel@epa.gov>  
**Cc:** Brown, Janet E (DEC) <janet.brown@dec.ny.gov>; Miller, John Y (DEC) <john.miller@dec.ny.gov>; Pat Van Rossem <patrick.vanrossem@nationalgrid.com>; michael.benoit@arcadis.com; Young, Terry W <terry.young2@arcadis.com>; 'jjalonzo@demaximis.com' <jjalonzo@demaximis.com>; stephen.raymond@gza.com; Daniel.amate@gza.com  
**Subject:** Agenda in question and answer format

Doug,

Attached is a copy of the agenda for tomorrow's meeting augmented with answers to a number of the questions. Also attached is a summary of the design considerations for the hydraulic relief system and a group of figures and drawings referred to in the answers on the agenda.

Looking forward to tomorrow's meeting.

Over the spring and summer a number of other packages of information have been shared to the EPA which contain information pertinent to the discussions. These are:

- 1) The October 2020 DEC CAG question responses
- 2) The May 2021 DEC Briefing Memo
- 3) July 2021 Arcadis memo that was previously provided to DEC

This is a very large group of files and I believe in the past has been provided over an FTP site. If you would like those documents set up on an FTP site again please let me know.

Thanks,

Dan

**Agenda**  
**USEPA-NYSDEC Meeting**  
**Former Citizens Gas Works MGP Site/Public Place**  
**Brooklyn, New York**  
**Date and Time: August 27, 2021, 11 a.m. EST**

In order to kick start the meeting, the agenda below has been augmented with answers an number of the questions

1. Introductions
2. Summary of Remedial Efforts at the Former Citizens Gas Works MGP Site  
Concise review of project schedule and accomplishments
3. Discussion of Recent or Planned Investigations
  - Investigations that were recently completed (e.g., February 2021 Grid sampling)
  - Public Place investigations (e.g., July 2021 Roux workplan)
  - Status of additional investigation at Parcel IV
  - Additional investigations and/or remediation planned by developers on Parcels I-III (if any)
4. Closure of the Sealed Bulkhead wall  
Approval of the design for the closure of the sealed bulkhead wall near the gas shaft / tunnel.
5. Groundwater Treatment/Hydraulic Relief
  - Completed work (e.g., five oil/water separators have been installed) **To date, approximately 690 linear feet of hydraulic relief piping and five of the planned six hydraulic relief manholes have been installed at the Site. The hydraulic relief manholes at the Citizens site are functionally equivalent to the oil-water separators that were installed at the Fulton site. Both structures include sumps for the removal of sediments and a mechanism for the removal of debris and other floatables (oil/grease, etc.) from the water collected by the system. In the case of the Citizens manholes, the removal mechanism for debris/floatables is a vortex-type hydrodynamic separator, whereas the oil-water separators at the Fulton site include a series of over-under weirs. The specific brand/model of hydrodynamic separator installed in each manhole (First Defense HC Stormwater Treatment Device, by Hydro International, Ltd.) was proposed by National Grid on December 3, 2019 and approved by USEPA on December 9, 2019. The oil-water separators at the Fulton site do not include any additional filtration/treatment processes beyond those noted above.**
  - Planned work (e.g., one more oil/water separators to be installed) **The remaining approximately 160 linear feet of hydraulic relief piping and final (sixth) manhole will be installed later this fall in conjunction with the completion of the bulkhead barrier wall at the existing gas transmission tunnel shaft on Parcel II of the Site. Each manhole can accommodate a peak flow rate of 18 cubic feet per second – roughly 18 times the design flow rate of the hydraulic relief piping connected to each manhole. These six manholes are more than sufficient to handle the flow conveyed by the hydraulic relief piping at the Site.**
  - Additional considerations/questions for discussion
    - Has the discharge from these systems been analyzed? If not already completed, should we consider collecting samples and evaluating the need to treat water collected in these systems prior to discharge (such as carbon treatment)? **The hydraulic relief system is not yet operational (it's not currently collecting water), so no sampling has been conducted to date. The primary purpose of the hydraulic relief system is to prevent structural damage to or excessive deflection of the bulkhead barrier wall system due to increases in groundwater mounding caused by future activities and conditions unrelated to the Citizens remediation project (e.g., Site development, climate change, etc.). Sampling of the treated water was not anticipated, nor was it**

requested by the agencies during the various review cycles of the hydraulic relief system design.

6. MGP Source Material Soil Removal

- Completed work (e.g., several subsurface tar-contaminated MGP structures and their contents and heavily-contaminated soils surrounding the structures have been removed; some material removed from depths to 26 feet below ground surface) **Pre-Remediation NAPL Monitoring Program (December 2010-May 2019): Recovery of approximately 48,000 gallons of fluid (groundwater/DNAPL).**
- Site Remediation (July 2019-May 2021):
  - Parcel I (Block 471, Lot 1):
    - Excavation of approximately 32,800 in-situ cubic yards (cy) of material from depths of between approximately 14 feet and 26 feet below grade (see attached mark-up of Drawing C-103 [Site Remedial Excavation Plan]);
    - Removal of buried piping encountered during the excavation activities;
    - Installation of new recovery wells CGRW-08 through CGRW-12 (see attached Drawing C-109 [Site Restoration and Final Grading Plan]);
    - Fine grading and surface restoration for remedial excavation areas 1 through 4;
    - Off-Site recycling of approximately 2,270 tons of clean concrete;
    - Off-Site disposal of approximately 265 tons of non-regulated construction and demolition (C&D) debris;
    - Off-Site treatment/disposal of approximately 41,765 tons of impacted material; and
    - Off-Site treatment/disposal of approximately 154,135 gallons of construction wastewater.
  - Parcel II (Block 471, Lot 100):
    - Selective demolition of existing bulkheads and removal of approximately 3,695 cy of material from depths of between approximately 5 feet and 13 feet below grade (see attached mark-up of Drawing C-103 [Site Remedial Excavation Plan]);
    - Installation of approximately 470 linear feet of new bulkhead barrier wall (see attached Drawing S-103A [Site Bulkhead Barrier Wall Plan]);
    - Installation of approximately 290 linear feet of new hydraulic relief piping and three new hydraulic relief manholes/treatment units (MH-3, MH-5, and MH-6; see attached Drawings C-106 [Hydraulic Relief System Plan and Profile – Sta. 0+00 to Sta. 4+75], C-107 [Hydraulic Relief System Plan and Profile – Sta. 4+75 to Sta. 9+25], C-504 [Hydraulic Relief System Details], and C-505 [Hydraulic Relief System Details]);
    - Off-Site recycling of approximately 2,925 tons of clean concrete;
    - Off-Site disposal of approximately 1,490 tons of non-regulated C&D debris; and
    - Off-Site treatment/disposal of approximately 205 tons of impacted material.
  - Parcel III (Block 471, Lot 200):
    - Excavation of approximately 16,905 cy of material from depths of between approximately 4 feet and 21 feet below grade (see attached mark-up of Drawing C-103 [Site Remedial Excavation Plan]);
    - Removal of buried piping encountered during the excavation activities;

- Installation of approximately 380 linear feet of new bulkhead barrier wall (see attached Drawing S-103A [Site Bulkhead Barrier Wall Plan]);
  - Installation of approximately 400 linear feet of new hydraulic relief piping and two new hydraulic relief manholes/treatment units (MH-1 and MH-2; see attached Drawing C-106 [Hydraulic Relief System Plan and Profile – Sta. 0+00 to Sta. 4+75], C-504 [Hydraulic Relief System Details], and C-505 [Hydraulic Relief System Details]);
  - Installation of two new temporary catch basins (CB-1 and CB-2; see attached Drawing C-106 [Hydraulic Relief System Plan and Profile – Sta. 0+00 to Sta. 4+75]);
  - Off-Site recycling of approximately 780 tons of clean concrete;
  - Off-Site treatment/disposal of approximately 22,990 tons of impacted material;
  - On-Site treatment/discharge of approximately 201,545 gallons of construction wastewater; and
  - Off-Site treatment/disposal of approximately 214,830 gallons of construction wastewater.
- Planned work (e.g., additional source removal on Parcel I in the vicinity of the former generator house, adjacent to the old brick sewer line that crosses the site and removal of contents of the former heavy oil pump pit [an intact subsurface reinforced concrete vault] and from areas adjacent to the foundation for the former pump house located on Parcel III **Completion of supplemental remedial excavation area in the vicinity of the former generator house on Parcel I of the Site (“Area 12”;** see attached mark-up of Drawing C-103 [Site Remedial Excavation Plan]);
  - Installation of bulkhead barrier wall closure at the existing gas transmission tunnel shaft on Parcel II of the Site (see attached Drawings S-103A [Site Bulkhead Barrier Wall Plan], S-105A [Bulkhead Barrier Wall Plan – Sta. 2+25 to Sta. 4+75], S-202 [Bulkhead Barrier Wall Profile – Sta. 2+25 to Sta. 4+75], S-313 [Bulkhead Barrier Wall Sections], S-505 [Bulkhead Barrier Wall Details], and S-510 [Bulkhead Barrier Wall Details]);
  - Installation of bulkhead pile cap on Parcels II and III of the Site;
  - Installation of approximately 160 linear feet of remaining hydraulic relief piping and the final (sixth) hydraulic relief manhole/treatment unit (MH-4; see attached Drawings C-106 [Hydraulic Relief System Plan and Profile – Sta. 0+00 to Sta. 4+75], C-107 [Hydraulic Relief System Plan and Profile – Sta. 4+75 to Sta. 9+25], C-504 [Hydraulic Relief System Details], and C-505 [Hydraulic Relief System Details]);
  - Installation of six new recovery wells on Parcel II of the Site (CGRW-13 through CGRW-18) and eight new recovery wells on Parcel III of the Site (CGRW-19I, CGRW-19D, CGRW-20I, CGRW-20D, CGRW-21I, CGRW-21D, CGRW-22I, and CGRW-22D; see attached Drawing C-109 [Site Restoration and Final Grading Plan]);
  - Installation of four new piezometers on Parcel II of the Site (CGPZ-07 through CGPZ-10) and two new piezometers on Parcel III of the Site (CGPZ-11 and CGPZ-12; see attached Drawing C-109 [Site Restoration and Final Grading Plan]); and
  - Completion of fine grading and surface restoration activities for remedial excavation area 12 on Parcel I of the Site and along the new bulkhead barrier wall on Parcels II and III of the Site.
  - The contents of the former heavy oil pump pit and surrounding soils on Parcel III of the Site were removed in May 2021.
  - Future Activities:
    - Preparation of Interim Site Management Plans and Construction Completion Reports;
    - Initiation of Site-wide operation, monitoring, and maintenance program, including NAPL monitoring/recovery;



- Installation of Site-wide soil cover system by property owners/developers in conjunction with future redevelopment projects; and
  - Preparation of Final Site Management Plans and Final Engineering Reports.
- Additional considerations/questions for discussion
    - Discussion of GEI RI (2007 borings) and Arcadis supplemental design investigation (2016)
    - February 2021 National Grid borings, and Roux Associates 2021 investigation work plan-DEC indicated that developers had expressed an interest in doing additional investigations to determine if and where development may encounter any remaining contamination that may require remediation/management in accordance with the SMP
    - Are RPs/developers considering any additional removal or ISS work?
    - Are there any areas near canal or near north or south boundaries where ISS might be worthwhile? [See responses under Agenda Item No. 5 below.](#)
7. Tar Recovery/Migration Controls
- Completed work (e.g., passive recovery wells) [Five of the planned 19 new passive DNAPL recovery wells have been installed on Parcel I of the Site \(CGRW-08 through CGRW-12\).](#)
  - Planned work (e.g., additional passive recovery wells, including wells near Huntington Street) [The 14 remaining passive DNAPL recovery wells \(CGRW 13 through CGRW-18, CGRW-19I, CGRW-19D, CGRW-20I, CGRW-20D, CGRW-21I, CGRW-21D, CGRW-22I, and CGRW-22D\), including those located near Huntington Street, will be installed later this year in conjunction with the Site restoration activities.](#)
  - Additional considerations/questions for discussion
    - How will the selection of locations of wells near Huntington Street be made? [In general, the proposed locations and screened intervals/depths of the recovery wells \(including those to be installed near Huntington Street\) are based on a number of factors, including: \(1\) the horizontal and vertical distribution of DNAPL-saturated soils \(i.e., soils containing potentially recoverable DNAPL\) on Parcels II and III, as identified during previous Site investigations; \(2\) DNAPL monitoring/recovery data for former high-producing recovery wells that were decommissioned at the beginning of the Site remediation work \(e.g., CGRW-07I, CGRW-07D, CGRW-05D, etc.\); and \(3\) the results of the DNAPL transmissivity evaluations conducted as part of the 2015 supplemental design investigation. Soil intervals containing DNAPL lenses, blebs, globs, or coatings were generally not considered given the limited potential for DNAPL recovery. Screened intervals may be adjusted in the field based on the subsurface conditions observed during the well drilling operations. Similarly, proposed well locations may be shifted if DNAPL-saturated intervals are not observed during well drilling operations.](#)
    - Would it be worthwhile to build in some redundancy by adding a wing wall or doing ISS in areas? [DNAPL transmissivity testing conducted at monitoring wells CGMW-41I and CGMW-43D and at recovery well CGRW-06I during the SDI showed a low potential for recoverability indicating that, where present, DNAPL in soil is relatively immobile \(Arcadis 2016\). Moreover, a review of existing data at the eastern \(Parcel II\) and southwestern \(Parcel III\) edges of the Site shows that DNAPL-saturated soils are limited in both horizontal and vertical extent in these areas, and generally are not present above elevation -40 feet NAVD88 \(i.e., within the design requirements for the bulkhead barrier wall\). ISS is similarly ill-suited for the Site given the depth/vertical distribution of DNAPL-saturated intervals and significant foundations that remain in the shallow zone, most of which are supported by timber piles that extend even deeper. The alignment of the existing Bond-Lorraine Street sewer \(a nominal 72-inch diameter pile-supported combined sewer\) at the northeast end of Parcel II also poses constructability challenges for](#)

both a wing wall and ISS in that area. In general, known areas of excavatable (or ISS-able) MGP source material are already addressed by the remedy.

- Will the SMP include a section that is specific to the removal of NAPL from the passive recovery wells? **The final SMP will include protocols for DNAPL monitoring and recovery (e.g., monitoring frequency, management/disposal of recovered DNAPL, criteria for completion NAPL recovery operations, etc.).**
- While not being prescriptive, can the SMP provide specific direction as to how removal of NAPL from the recovery wells should be performed to reduce odors and exposures for those that might be using the property post development? **The SMP can include general protocols/best practices to mitigate fugitive odors during DNAPL monitoring/recovery operations.**

#### 8. Vapor Intrusion


- Completed work (e.g., removal of MGP source materials; NAPL recovery)
- Planned work (e.g., SMP will require evaluation of potential for vapor intrusion and mitigation measures; NYCOER's practice is to require vapor barriers on all new construction).
- Additional considerations/questions for discussion
  - Rather than just identify that other evaluations or programs might require VI evaluations or measures, can we be more proactive and require or work with developers to ensure barriers and/or piping are included in the design of any new buildings?
  - Measures required for the Con Ed cleanup on 18<sup>th</sup> Street
- **Regarding the remedial elements for the W. 18<sup>th</sup> OU3 site the element #2 stated that a subsurface barrier wall will be installed around the site on three sides. The original plan was to utilize a jet-grout wall around the perimeter. The actual barrier wall constructed consisted of water-tight (sealed with Adeka P-200) sheet pile walls that keyed into a clay layer approximately 35 feet below ground surface around 2 ½ sides of the perimeter. The remaining barrier wall utilized the existing grout wall and sheet pile from an adjacent building as the other 1 ½ sides of the perimeter. The method for connecting the new sheet pile to the existing grout wall and sheet pile was through the use of a grout tie-in wall. This grout tie-in wall was simply five 6-inch diameter overlapping borings that extended into the same clay layer and "connected" the site sheeting with the existing grout wall and sheet pile.**
- 
- **At the Citizens site the sheetpile were installed to an elevation of -40' (which is approximately 42 feet below ground surface) over approximately 880 linear feet. As shown in multiple investigations the tar at depth is discontinuous in areal extent and in varying quantities making the method of grouting at the bottom of the entire wall infeasible and unnecessary.**
- 
- **The remedial element #3 stated that the subsurface floor and walls of the new building would be isolated from the remaining contamination, using a mud slab on the floor and waterproofing on the floor and walls. First, a mud slab is essentially just that – a layer of concrete with no reinforcement. The primary purpose is on projects with high water tables (the bottom basement slab in this case was 8-9 feet below the water table) the use of the mud slab establishes a working platform to maintain the structural integrity at the base of the building footings, and a stable surface for installing waterproofing membrane. It is not used for remedial purposes even though it could be viewed that way. The original plan was to install a 2-foot thick mud slab on the floor, but that was changed to a 6-inch slab with 18 inches of clean material underneath. The vapor/waterproofing was then placed over the slab and up the outside of the foundation walls, and the basement floor poured over the top of this membrane.**
- 
- **At the Citizens site there isn't a shallow water table on the western portion of the site but the foundations could come close on the eastern portion (closer to the canal). Most new**

commercial construction includes this vapor/waterproofing membrane already, but, if not, could easily be requested at a minimal cost to the developer.

○

9. Request by Members of CAG for USEPA to Evaluate Citizens/Public Place to Calculate a Hazard Ranking Score
  - HRS evaluation of remediated site?



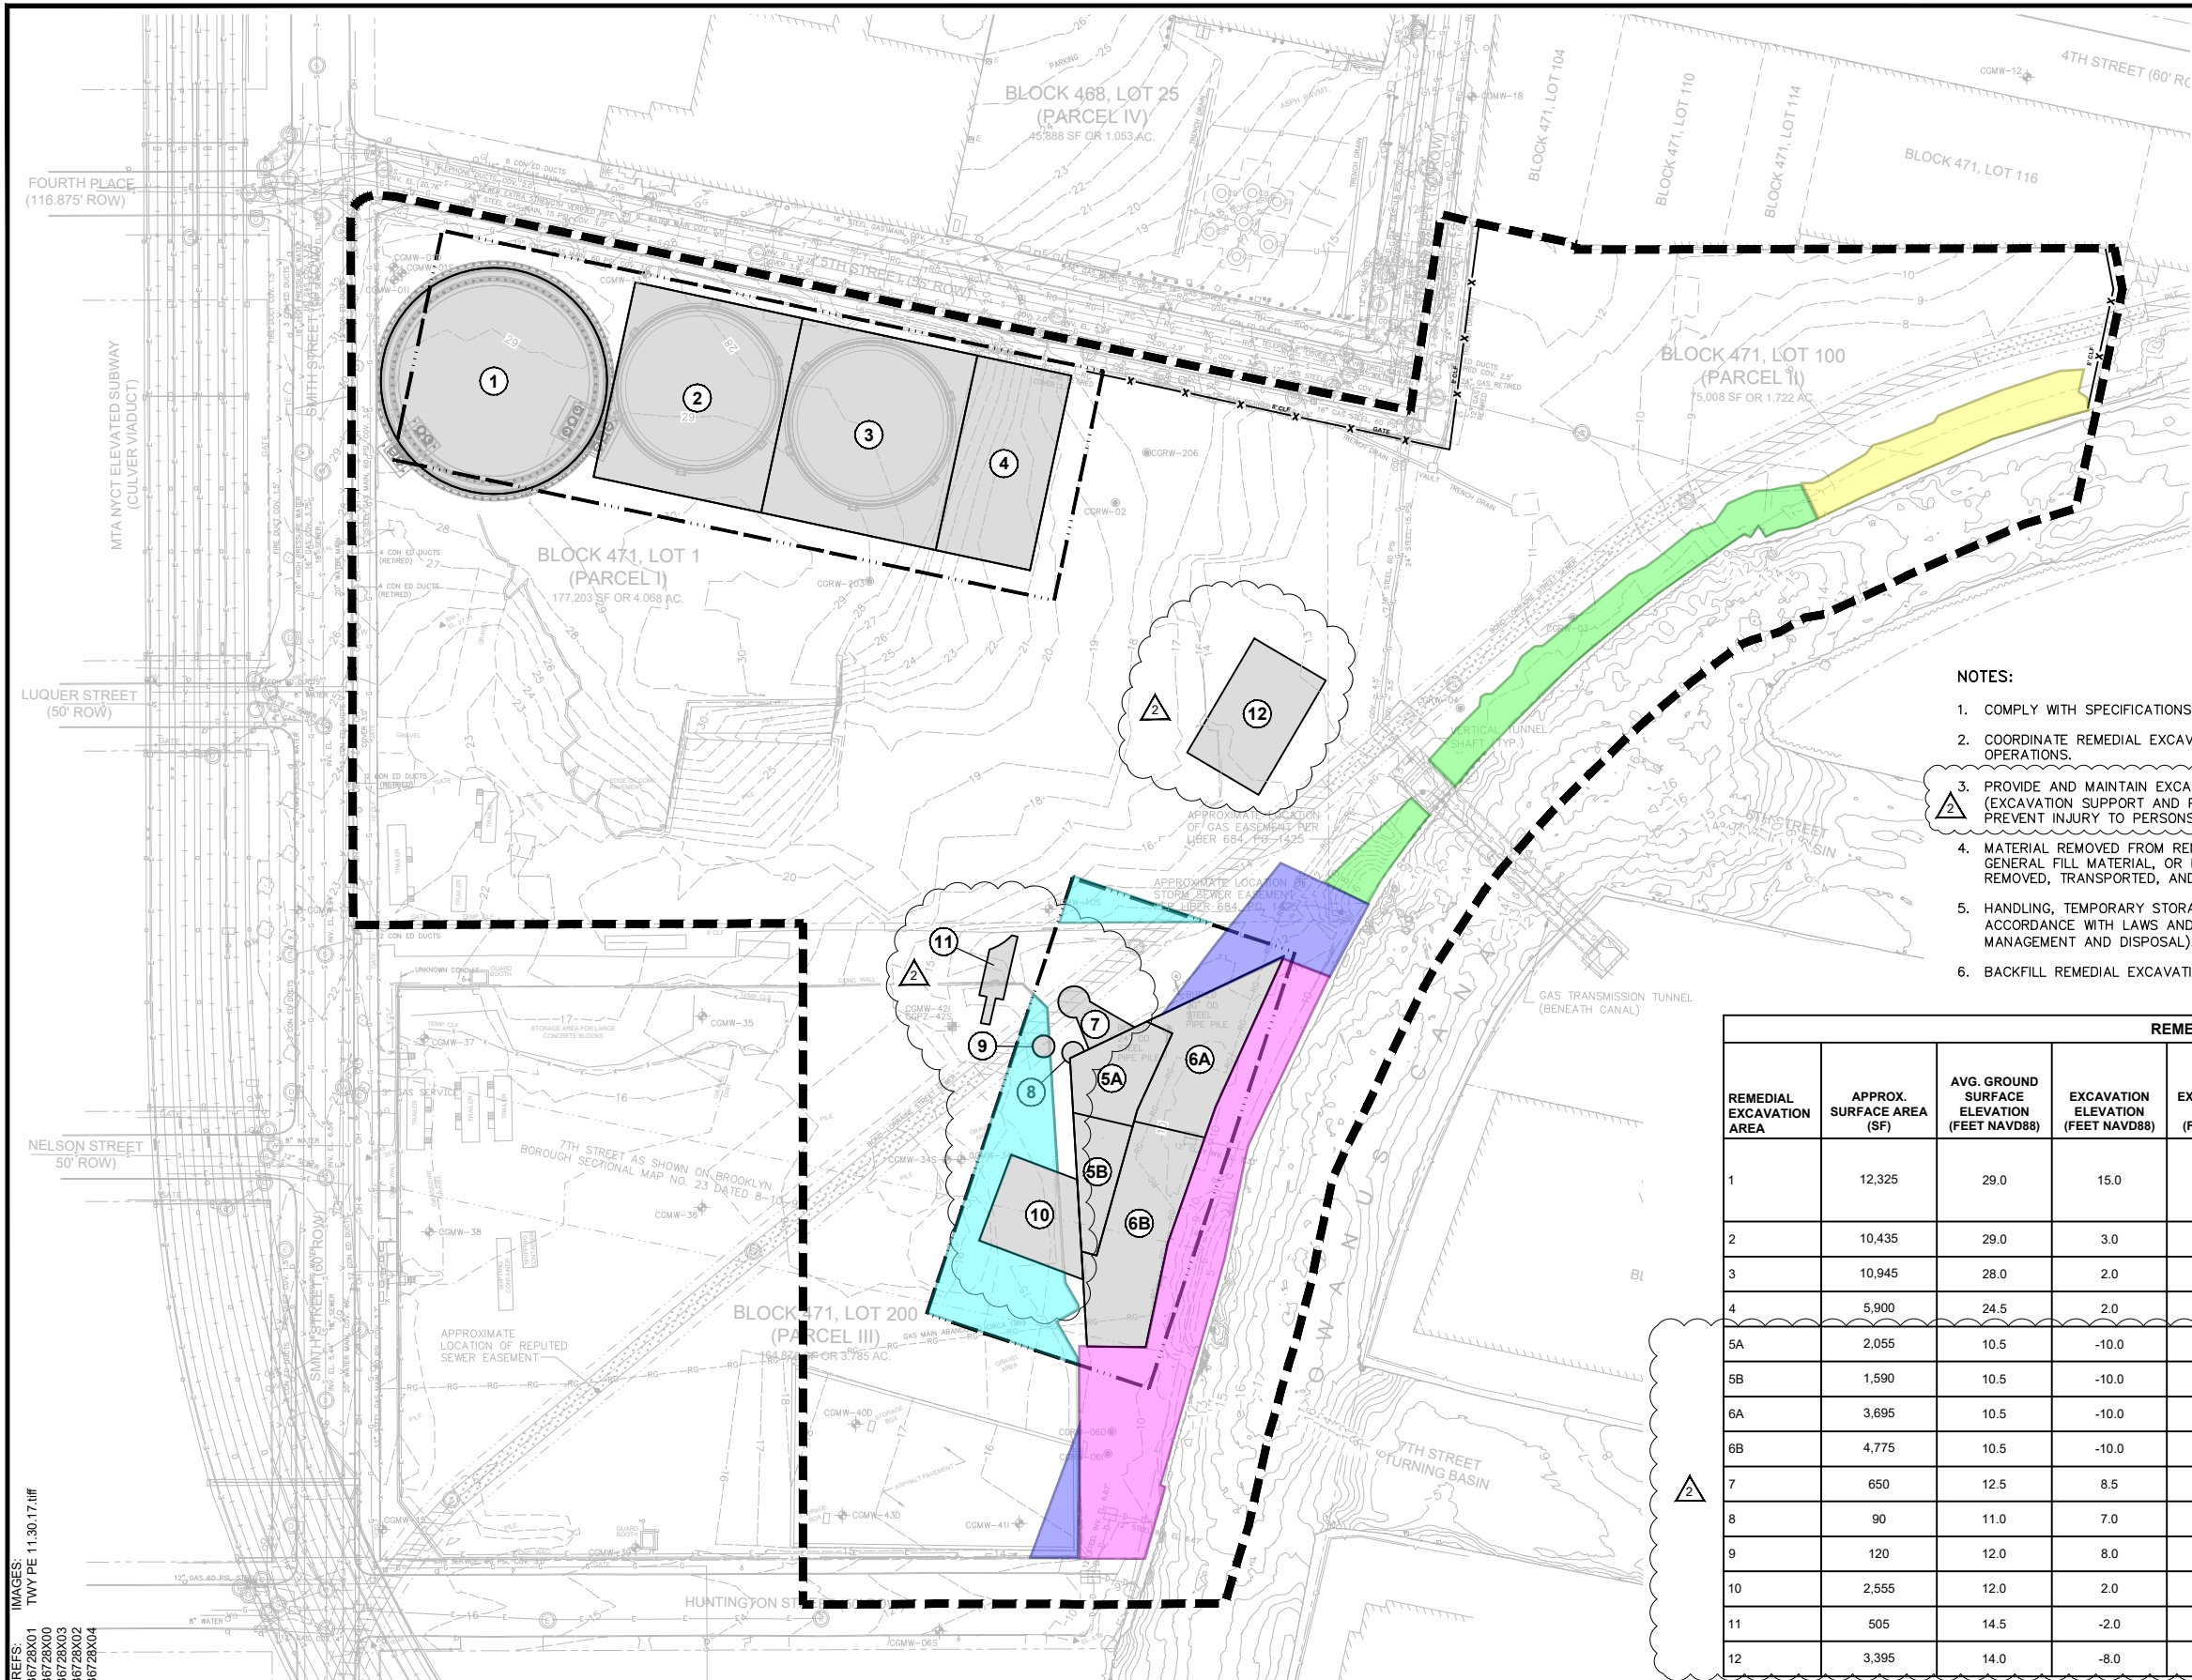

SUPPLEMENTAL EXCAVATION LEGEND:

\*\*ALL EXCAVATION LIMITS ARE APPROXIMATE\*\*

- ADDITIONAL EXCAVATION TO APPROX. 5 FEET BELOW GRADE TO FACILITATE SELECTIVE DEMOLITION OF EXISTING PARCEL II BULKHEAD
- ADDITIONAL EXCAVATION TO APPROX. 13 FEET BELOW GRADE TO FACILITATE SELECTIVE DEMOLITION OF EXISTING PARCEL II BULKHEAD
- ADDITIONAL EXCAVATION TO APPROX. 8-10 FEET BELOW GRADE TO FACILITATE INSTALLATION OF ANCHORS/TIE RODS FOR NEW PARCEL III BULKHEAD BARRIER WALL
- ADDITIONAL EXCAVATION TO APPROX. 6-7 FEET BELOW GRADE TO FACILITATE INSTALLATION OF ANCHORS/TIE RODS FOR NEW PARCEL III BULKHEAD BARRIER WALL
- ADDITIONAL EXCAVATION TO APPROX. 5 FEET BELOW GRADE TO FACILITATE INSTALLATION OF TEMPORARY FABRIC STRUCTURE FOR PARCEL III REMEDIAL EXCAVATION WORK

LEGEND:


- REMEDIAL EXCAVATION AREA (APPROXIMATE)
- AREA IDENTIFIER
- CONCEPTUAL LIMIT OF TEMPORARY FABRIC STRUCTURE(S)

NOTES:

- COMPLY WITH SPECIFICATIONS SECTION 31 23 00 (EXCAVATION AND FILL).
- COORDINATE REMEDIAL EXCAVATION AND BACKFILLING OPERATIONS WITH SELECTIVE DEMOLITION AND PILE DRIVING OPERATIONS.
- PROVIDE AND MAINTAIN EXCAVATION PROTECTION SYSTEM(S) IN ACCORDANCE WITH SPECIFICATIONS SECTION 31 50 00 (EXCAVATION SUPPORT AND PROTECTION), DRAWINGS S-101, S-102, AND S-108, AND LAWS AND REGULATIONS TO PREVENT INJURY TO PERSONS AND PROPERTY, INCLUDING SURFACE STRUCTURES AND UNDERGROUND FACILITIES.
- MATERIAL REMOVED FROM REMEDIAL EXCAVATION AREAS THAT DOES NOT COMPLY WITH THE REQUIREMENTS FOR GENERAL FILL MATERIAL, OR IS IN EXCESS OF THE QUANTITY REQUIRED FOR GENERAL FILL MATERIAL, SHALL BE REMOVED, TRANSPORTED, AND DISPOSED OF AWAY FROM THE SITE, UNLESS OTHERWISE APPROVED BY ENGINEER.
- HANDLING, TEMPORARY STORAGE, TRANSPORTATION, AND DISPOSAL OF REMEDIAL EXCAVATION WASTE SHALL BE IN ACCORDANCE WITH LAWS AND REGULATIONS AND SPECIFICATIONS SECTION 02 60 05 (CONTAMINATED WASTE MANAGEMENT AND DISPOSAL).
- BACKFILL REMEDIAL EXCAVATION AREAS TO THE SUBGRADE ELEVATIONS SHOWN OR INDICATED ON DRAWING C-108.

REMEDIAL EXCAVATION SCHEDULE

REMEDIAL EXCAVATION AREA	APPROX. SURFACE AREA (SF)	AVG. GROUND SURFACE ELEVATION (FEET NAVD88)	EXCAVATION ELEVATION (FEET NAVD88)	AVG. EXCAVATION DEPTH (FEET BGS)	ESTIMATED EXCAVATION VOLUME (CY)	APPROX. DEPTH OF EXISTING MATERIAL POTENTIALLY SUITABLE FOR REUSE AS GENERAL FILL MATERIAL (FEET BGS)	ESTIMATED VOLUME OF EXISTING MATERIAL POTENTIALLY SUITABLE FOR REUSE AS GENERAL FILL MATERIAL (CY)	BACKFILL MATERIAL
1	12,325	29.0	15.0	14.0	6,445	0.0 - 10.0	875	CLSM / GENERAL FILL MATERIAL (SEE DRAWING S-101)
2	10,435	29.0	3.0	26.0	9,975	0.0 - 8.0	1,525	GENERAL FILL MATERIAL
3	10,945	28.0	2.0	26.0	11,725	0.0 - 8.0	1,130	GENERAL FILL MATERIAL
4	5,900	24.5	2.0	22.5	4,450	0.0 - 8.0	750	GENERAL FILL MATERIAL
5A	2,055	10.5	-10.0	20.5	1,565	--	0	GENERAL FILL MATERIAL
5B	1,590	10.5	-10.0	20.5	1,270	--	0	GENERAL FILL MATERIAL
6A	3,695	10.5	-10.0	20.5	2,810	--	0	GENERAL FILL MATERIAL
6B	4,775	10.5	-10.0	20.5	3,975	--	0	GENERAL FILL MATERIAL
7	650	12.5	8.5	4.0	100	--	0	GENERAL FILL MATERIAL
8	90	11.0	7.0	4.0	15	--	0	GENERAL FILL MATERIAL
9	120	12.0	8.0	4.0	20	--	0	GENERAL FILL MATERIAL
10	2,555	12.0	2.0	10.0	950	--	0	GENERAL FILL MATERIAL
11	505	14.5	-2.0	16.5	310	--	0	GENERAL FILL MATERIAL
12	3,395	14.0	-8.0	22.0	2,770	--	0	GENERAL FILL MATERIAL

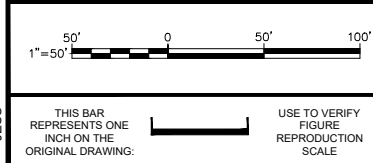

No.	Date	Revisions	By	Ckd
2	7/29/2021	ADDED SUPPLEMENTAL REMEDIAL EXCAVATION AREAS ON PARCELS I AND II AND UPDATED SCHEDULE	MJB	MJB
1	2/4/2019	ADDED APPROX. DEPTHS AND EST. VOLUMES OF REUSE MATERIAL	APG	MJB

Professional Engineer's Name		
TERRY W. YOUNG		
Professional Engineer's No.		
074847		
State	Date Signed	Project Mgr.
NY	11/30/2017	MJB
Designed by	Drawn by	Checked by
APG	MJW	MJB

**DRAFT**  
**NOT FOR CONSTRUCTION**



ARCADIS OF NEW YORK, INC.  
NO ALTERATIONS PERMITTED HEREON EXCEPT AS PROVIDED UNDER SECTION 7209 SUBDIVISION 2 OF THE NEW YORK STATE EDUCATION LAW


Design & Consultancy  
for natural and built assets

**SITE REMEDIAL EXCAVATION PLAN**

NATIONAL GRID USA • BROOKLYN, NEW YORK  
FORMER CITIZENS GAS WORKS MANUFACTURED GAS PLANT SITE  
CARROLL GARDENS/PUBLIC PLACE  
BOROUGH OF BROOKLYN, KINGS COUNTY, NEW YORK  
SITE REMEDIATION

Arcadis Project No. 80036728.0001.00003
Date NOVEMBER 2017
Arcadis One Lincoln Center 110 West Fayette Street, Suite 300 Syracuse, NY 13202 Tel. 315.446.9120

**C-103**

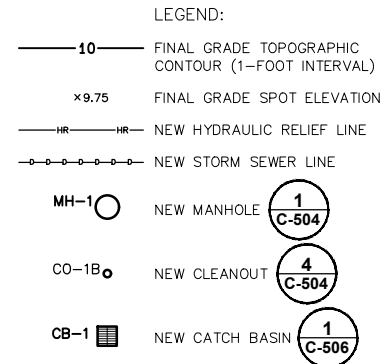

No.	Date	Revisions	By	Ckd
3	8/13/2021	ADDED NEW CLOSURE WALL, REVISED BULKHEAD ALIGNMENT TO REFLECT AS-BUILT CONDITIONS, AND REVISED FINAL GRADE CONTOURS	DGN	MJB
2	1/10/2020	REVISED PIPING ALIGNMENT AT MANHOLES, ADDED ADDITIONAL MANHOLE, AND REVISED STRUCTURE LABELS	DGN	MJB
1	2/4/2019	REVISED BULKHEAD ANCHORS TO REFLECT NEW DESIGN	RPK	MJB

THIS DRAWING IS THE PROPERTY OF THE ARCADIS ENTITY IDENTIFIED IN THE TITLE BLOCK AND MAY NOT BE REUSED OR ALTERED IN WHOLE OR IN PART WITHOUT THE EXPRESS WRITTEN PERMISSION OF SAH

Professional Engineer's Name	
<b>TERRY W. YOUNG</b>	
Professional Engineer's No.	
074847	
State	Date Signed
NY	11/30/2017
Designed by	Drawn by
JSB	MJW



ARCADIS OF NEW YORK, INC.

## HYDRAULIC RELIEF SYSTEM PLAN AND PROFILE STA. 0+00 TO STA. 4+75

Arcadis Project No. B0036728.0001.00003
Date NOVEMBER 2017
Arcadis One Lincoln Center 110 West Fayette Street, Syracuse, NY 13202 Tel. 315.446.9120

**C-106**

C:\Users\jharis\ACD\docs\Arcadis\AUS-NATIONAL GRID-FORMER CITIZENS MGP-BROOKLYN New York\Project Files\2021\01-1n Progress\01-DWG\CONTRACT-C-106 C-107-HYD RELIEF PLAN PROF.DWG LAYOUT: C-107 PLOTTED: 8/17/2021 2:29 PM PLOTSTYLETABLE: ---- PLOTTED: 8/17/2021 2:44 PM BY: JHARRIS, JESS


IMAGES:  
Arcadis Logo BW\_2021.PNG  
LAB FE 11.30.17.tif  
LAW FE 24.19.17.tif  
TWT FE 11.30.17.tif  
  
XREFS:  
36728X01  
36728X02  
36728X03ALTERNATE  
36728X04  
36728X08  
36728X02  
36728X09\_AS BUILT

0 20' 40'  
HORIZONTAL SCALE: 1"=20'  
0 4'  
VERTICAL SCALE (10x EXAGGERATED): 1"=2'  
  
THIS BAR REPRESENTS ONE INCH ON THE ORIGINAL DRAWING.  
USE TO VERIFY FIGURE REPRODUCTION SCALE

3	8/13/2021	ADDED NEW CLOSURE WALL, REVISED BULKHEAD ALIGNMENT TO REFLECT AS-BUILT CONDITIONS, AND REVISED FINAL GRADE CONTOURS	DGN	MJB
2	11/13/2020	UPDATED BULKHEAD TERMINATIONS AND REVISED LOCATIONS OF CLEANOUTS CO-5A AND CO-5B	DGN	MJB
1	1/10/2020	REVISED PIPING ALIGNMENT AT MANHOLES, LOWERED EL. OF HYDRAULIC RELIEF PIPING, AND REVISED STRUCTURE LABELS	DGN	MJB
No.	Date	Revisions	By	Ckd

THIS DRAWING IS THE PROPERTY OF THE ARCADIS ENTITY IDENTIFIED IN THE TITLE BLOCK AND MAY NOT BE REUSED OR ALTERED IN WHOLE OR IN PART WITHOUT THE EXPRESS WRITTEN PERMISSION OF SAME.

Professional Engineer's Name  
**TERRY W. YOUNG**  
Professional Engineer's No.  
074847  
State  
NY  
Date Signed  
11/30/2017  
Project Mgr.  
MJB  
Designed by  
JSB  
Drawn by  
MJW  
Checked by  
BRT

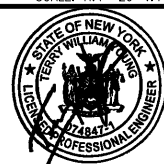

ARCADIS OF NEW YORK, INC.  
NO ALTERATIONS PERMITTED HEREON EXCEPT AS PROVIDED UNDER SECTION 7209 SUBDIVISION 2 OF THE NEW YORK STATE EDUCATION LAW


NATIONAL GRID USA • BROOKLYN, NEW YORK  
FORMER CITIZENS GAS WORKS MANUFACTURED GAS PLANT SITE  
CARROLL GARDENS/PUBLIC PLACE  
BOROUGH OF BROOKLYN, KINGS COUNTY, NEW YORK  
SITE REMEDIATION  
**HYDRAULIC RELIEF SYSTEM PLAN AND PROFILE  
STA. 4+75 TO STA. 9+25**

Arcadis Project No.  
80036728.0001.00003  
Date  
NOVEMBER 2017  
Arcadis  
One Lincoln Center  
110 West Fayette Street, Suite 300  
Syracuse, NY 13202  
Tel. 315.446.9120

**C-107**

LEGEND:  
—10— FINAL GRADE TOPOGRAPHIC CONTOUR (1-FOOT INTERVAL)  
x8.0 FINAL GRADE SPOT ELEVATION  
—HR—HR NEW HYDRAULIC RELIEF LINE  
MH-5 NEW MANHOLE  
CO-5B NEW CLEANOUT

1  
C-504  
4  
C-504

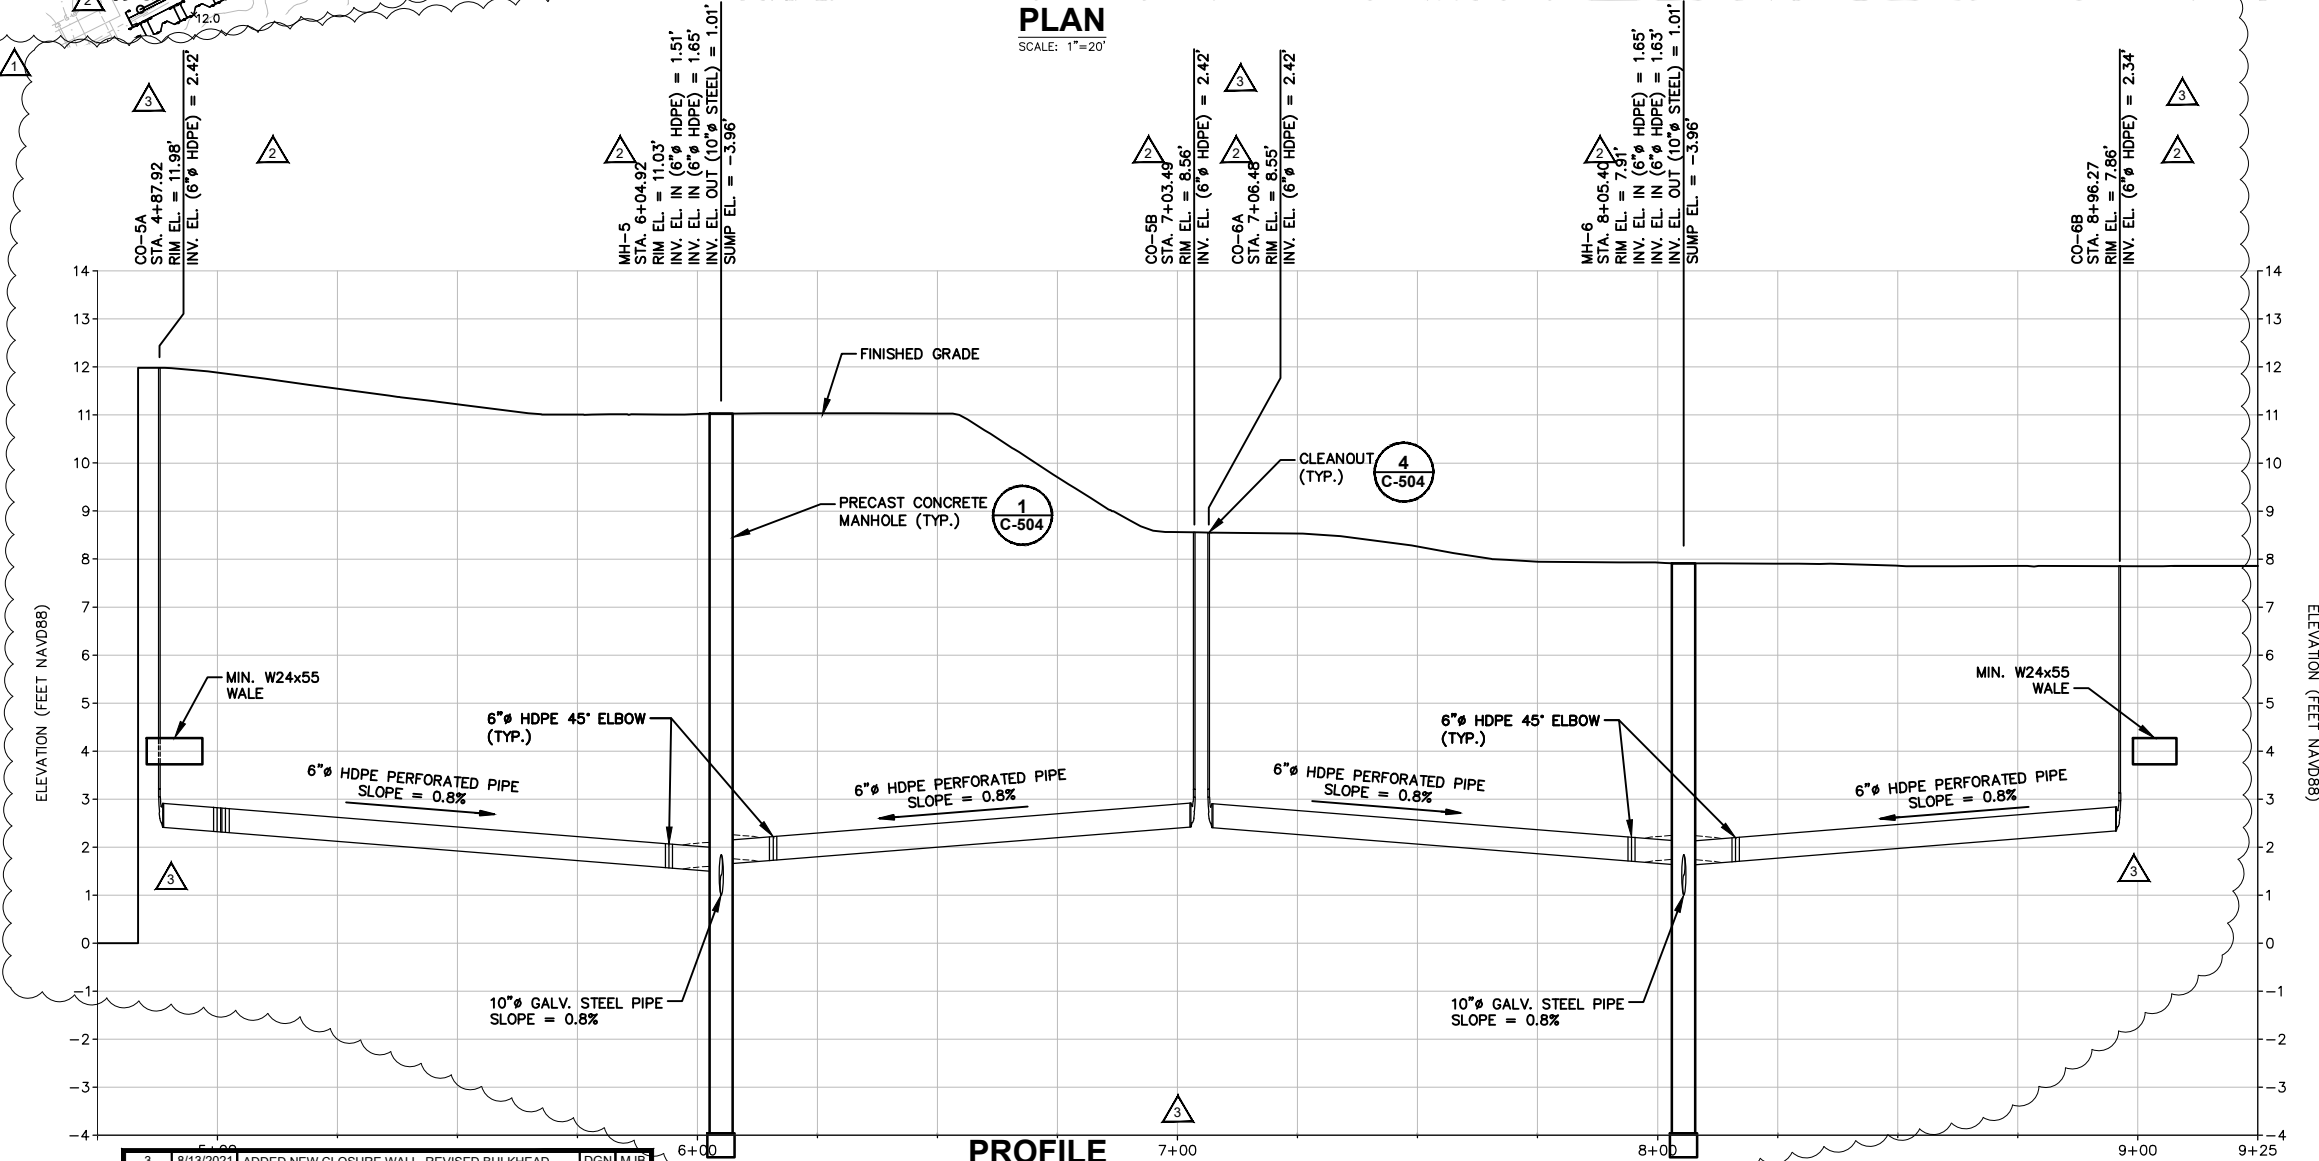


**PLAN**  
SCALE: 1"=20'

**PROFILE**  
SCALE: H: 1"=20' V: 1"=2'








C:\Users\jharris\ACD\CDocs\Arcadis\US-NATIONAL GRID-FORMER CITIZENS MGP-BROOKLYN New York\Project Files\2021\01-1-in Progress\01-DWG\CONTRACT-C-109-REST AND FINAL GRAD PLAN.dwg LAYOUT: C-109 SAVED: 8/17/2021 2:38 PM PLOTSTYLETABLE: ---- PLOTTED: 8/18/2021 12:34 PM BY: HARRIS, JESS

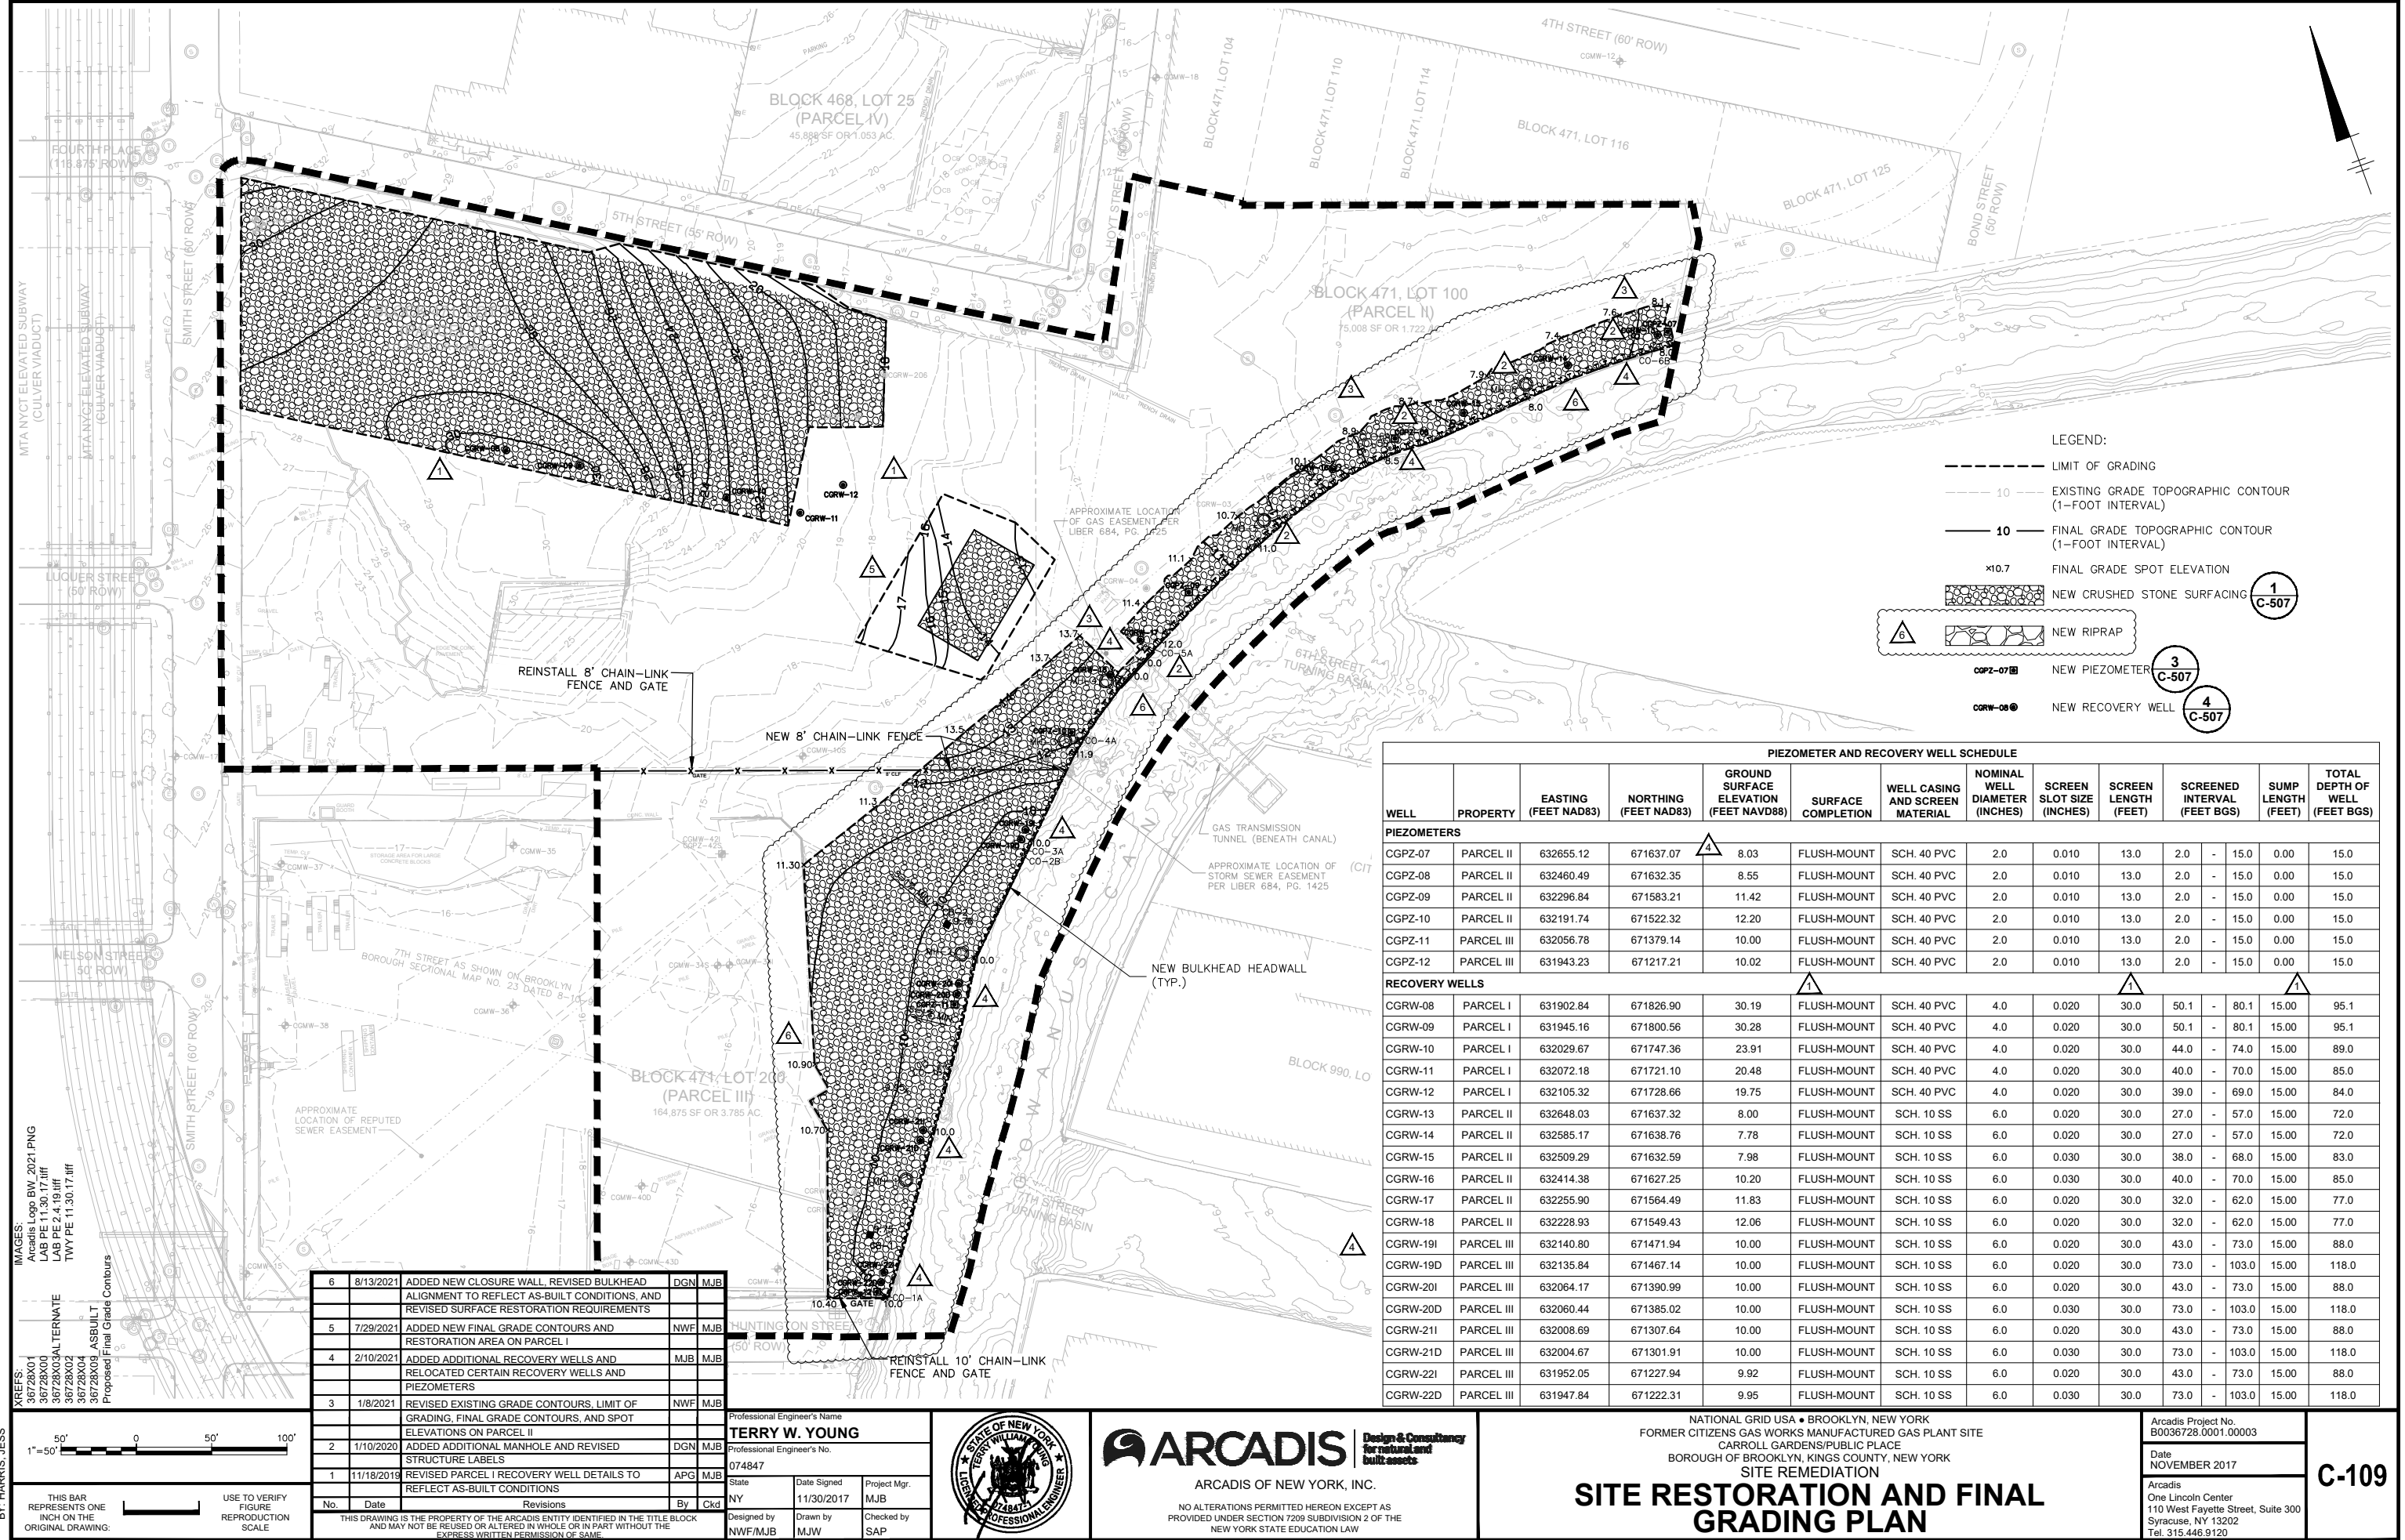



CITY: SYRACUSE, NY DIV/GROUP: ENVCAD DB: B GETT'S B DECLERO, LPOSENAUER, J. HARRIS  
C:\Users\mwasilewski\BIM 360\Arcadis\ANA - National Grid\Project Files\FORMER CITIZENS GAS WORKS MGP SITE\2020\0300040140\1-DWG\G36728\_C-504.dwg LAYOUT: C-504  
PLOT/STYLETABLE: --- PLOTTED: 11/22/2020 6:11 PM BY: WASILEWSKI, MATT  
XREFS: 36728X00 TWP PE 11.30.17.tif

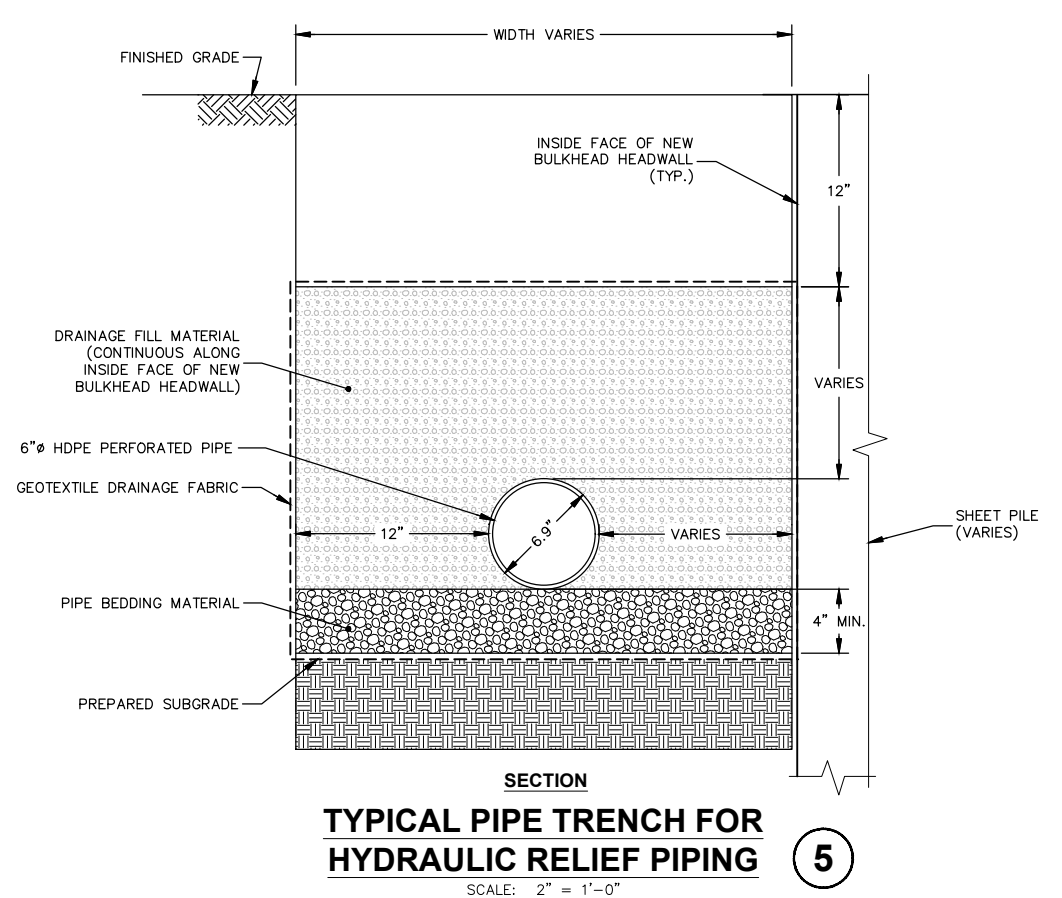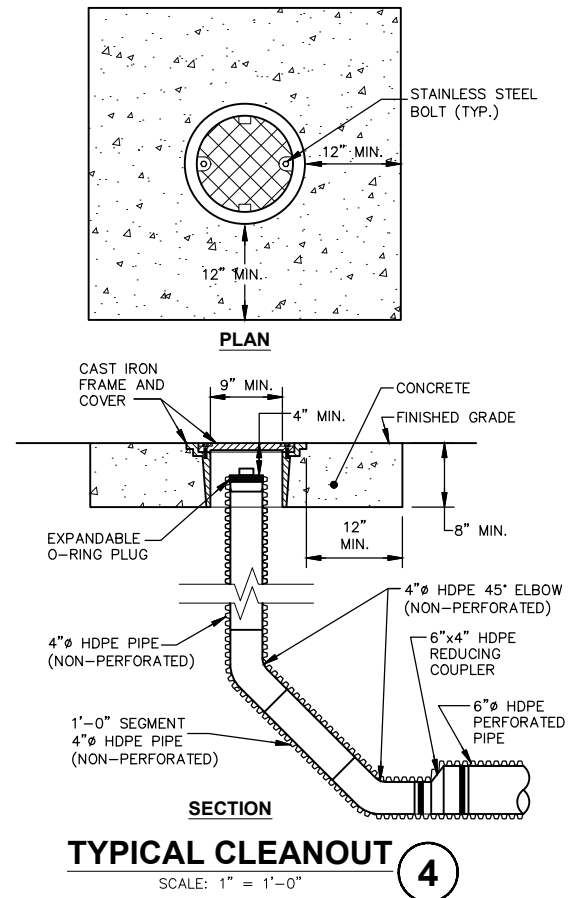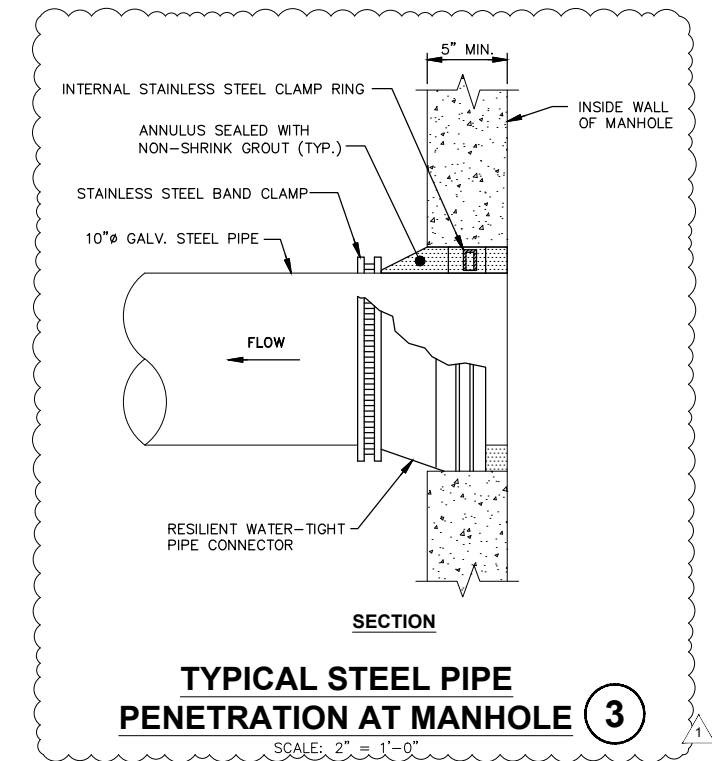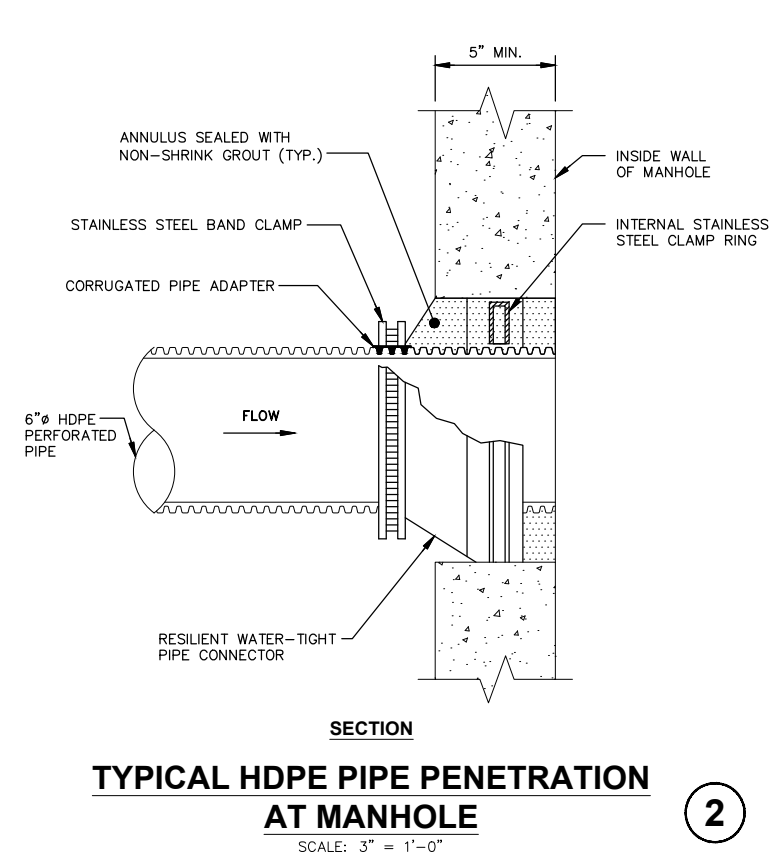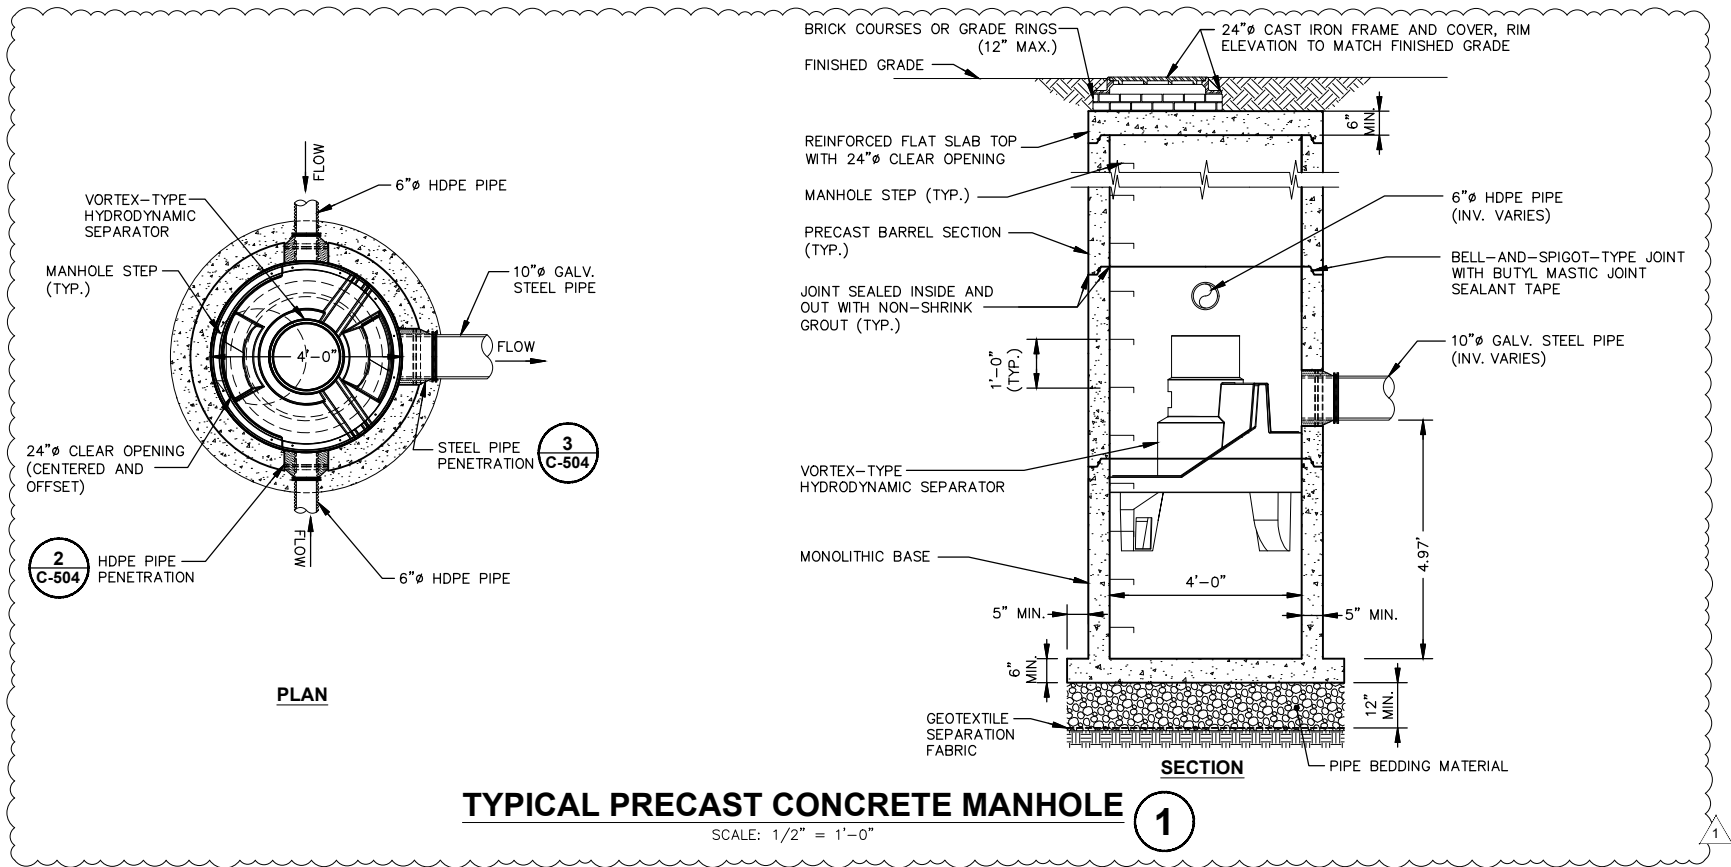

SCALE AS INDICATED						Professional Engineer's Name	
						TERRY W. YOUNG	
						Professional Engineer's No.	
						074847	
1		1/10/2020	REVISED DETAILS 1 AND 3 TO REFLECT CHANGES TO		DGN	MJB	
			HYDRAULIC RELIEF SYSTEM				
No.		Date	Revisions		By	Ckd	
THIS DRAWING IS THE PROPERTY OF THE ARCADIS ENTITY IDENTIFIED IN THE TITLE BLOCK AND MAY NOT BE REUSED OR ALTERED IN WHOLE OR IN PART WITHOUT THE EXPRESS WRITTEN PERMISSION OF SAME.							
THIS BAR REPRESENTS ONE INCH ON THE ORIGINAL DRAWING:		USE TO VERIFY FIGURE REPRODUCTION SCALE				Professional Engineer's Name	
						TERRY W. YOUNG	
						Professional Engineer's No.	
						074847	
						State	
						NY	
						Date Signed	
						11/30/2017	
						Project Mgr.	
						MJB	
						Designed by	
						JSB	
						Drawn by	
						MJW	
						Checked by	
						BRT	

Design & Consulting  
for natural and  
built assets.

ARCADIS OF NEW YORK, INC.

NO ALTERATIONS PERMITTED HEREON EXCEPT AS  
PROVIDED UNDER SECTION 7209 SUBDIVISION 2 OF THE  
NEW YORK STATE EDUCATION LAW

NATIONAL GRID USA • BROOKLYN, NEW YORK  
FORMER CITIZENS GAS WORKS MANUFACTURED GAS PLANT SITE  
CARROLL GARDENS/PUBLIC PLACE  
BOROUGH OF BROOKLYN, KINGS COUNTY, NEW YORK  
SITE REMEDIATION

Hydraulic Relief System Details


Arcadis Project No.  
80036728.0001.00003

Date  
NOVEMBER 2017


Arcadis  
One Lincoln Center  
110 West Fayette Street, Suite 300  
Syracuse, NY 13202  
Tel. 315.446.9120

C-504


CITY: SYRACUSE, NY DIV/GROUP: ENVCAD DB: B GETT'S B DECLERO LPOSENAUER J HARRIS  
C:\Users\jharris\BIN\360\Arcadis\ANA - National Grid\Project Files\FORMER CITIZENS GAS WORKS MGP SITE\2020\300\0401\01-DWG\36728\_C-505.dwg LAYOUT: C-505  
PLOTTED: 11/16/2020 6:37 AM BY: HARRIS, JESS  
XREFS: 36728X00  
IMAGES: 36728X00  
checkvalve.jpg  
TWY PE 11.30.17.tif

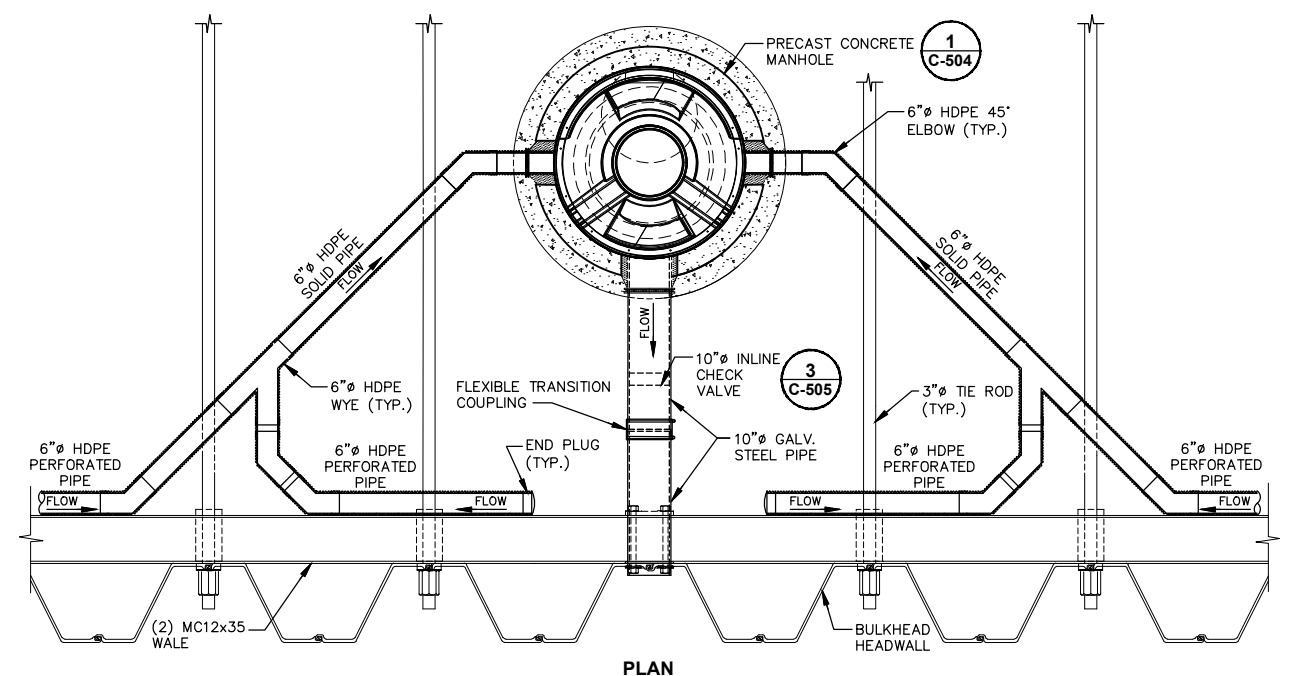


**TYPICAL STEEL PIPE CONNECTION AT ANCHORED TIEBACK WALL**  
SCALE: 1/2" = 1'-0"

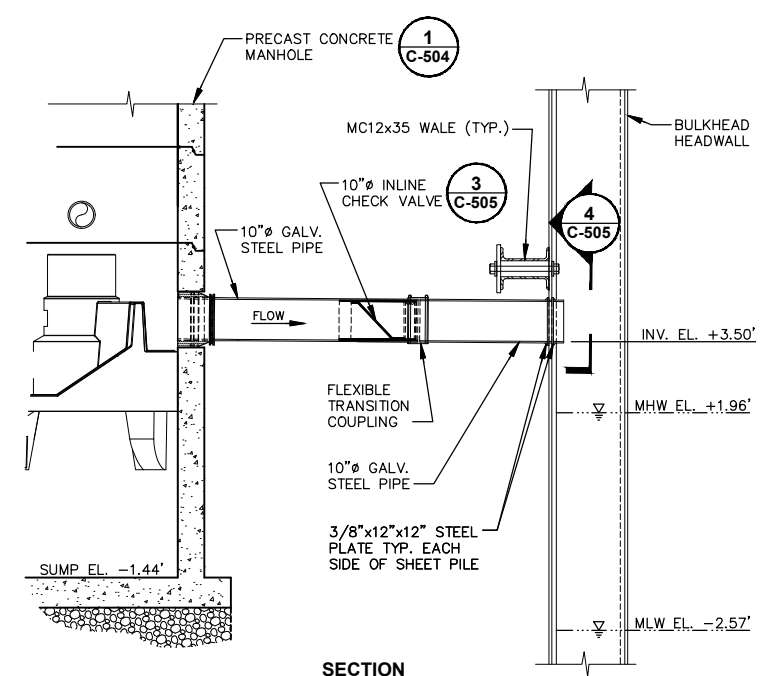


**SECTION**

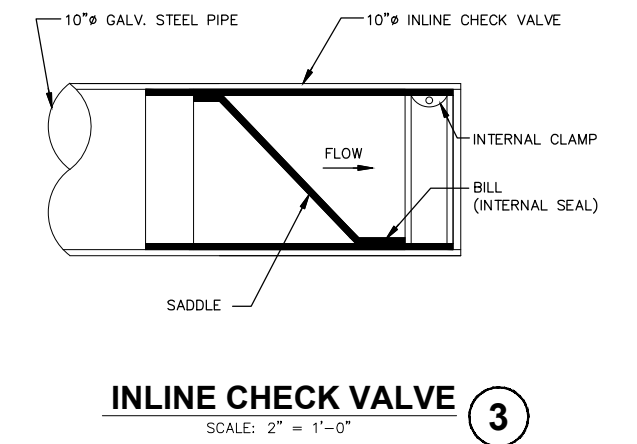


**INLINE CHECK VALVE**  
SCALE: 2" = 1'-0"

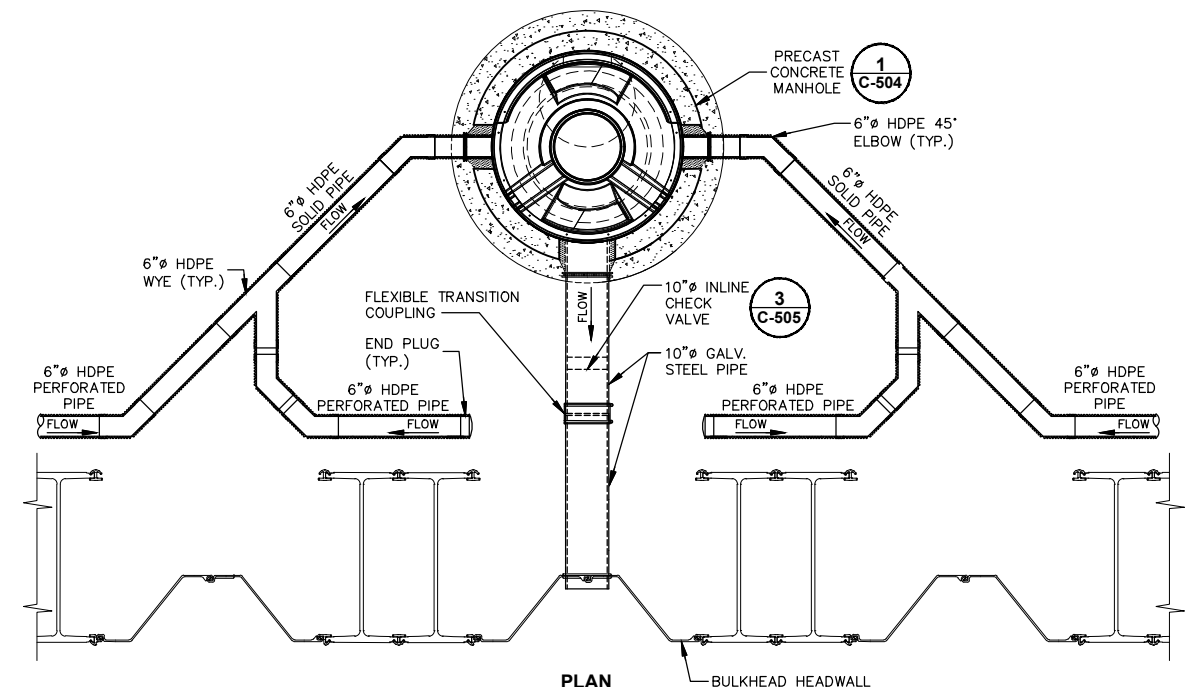

**TYPICAL STEEL PIPE CONNECTION AT CANTILEVERED COMBINATION WALL**  
SCALE: 1/2" = 1'-0"

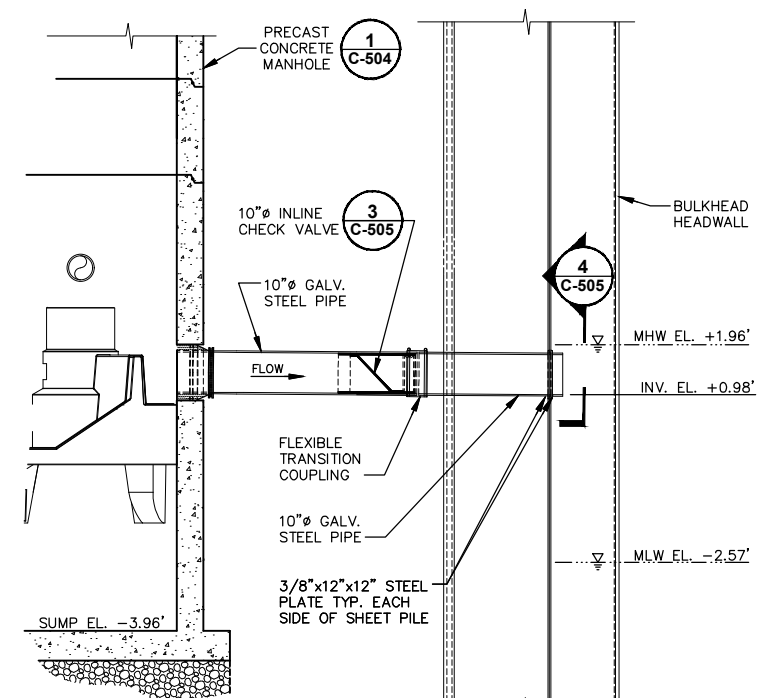

**SECTION**

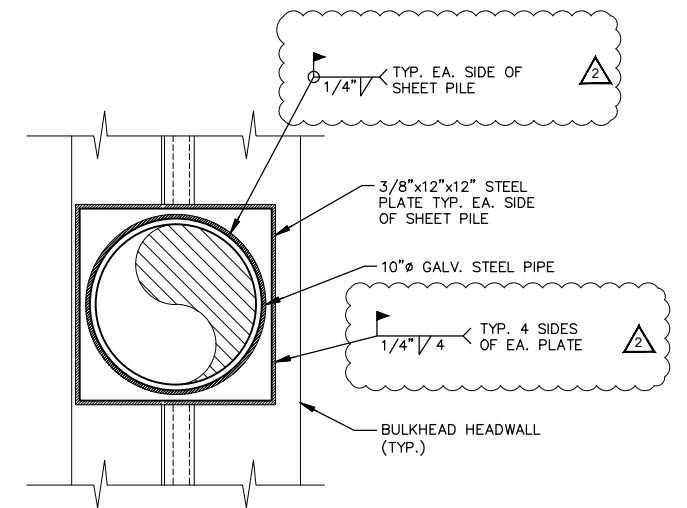

**TYPICAL STEEL PIPE PENETRATION AT BULKHEAD**  
SCALE: 2" = 1'-0"

SCALE AS INDICATED	
THIS BAR REPRESENTS ONE INCH ON THE ORIGINAL DRAWING.	USE TO VERIFY FIGURE REPRODUCTION SCALE

No.	Date	Revisions	By	Ckd
2	11/13/2020	CORRECTED WELD REQUIREMENTS IN DETAIL 4	LAB	MJB
1	1/10/2020	REVISED DETAILS 1 AND 2 TO REFLECT CHANGES TO HYDRAULIC RELIEF SYSTEM	RPK	MJB

Professional Engineer's Name <b>TERRY W. YOUNG</b>	
Professional Engineer's No. 074847	
State NY	Date Signed 11/30/2017
Designed by JSB	Project Mgr. MJB
Drawn by MJW	Checked by BRT




**ARCADIS** Design & Consultancy for natural and built assets  
ARCADIS OF NEW YORK, INC.  
NO ALTERATIONS PERMITTED HEREON EXCEPT AS PROVIDED UNDER SECTION 2209 SUBDIVISION 2 OF THE NEW YORK STATE EDUCATION LAW

NATIONAL GRID USA • BROOKLYN, NEW YORK  
FORMER CITIZENS GAS WORKS MANUFACTURED GAS PLANT SITE  
CARROLL GARDENS/PUBLIC PLACE  
BOROUGH OF BROOKLYN, KINGS COUNTY, NEW YORK  
SITE REMEDIATION

**HYDRAULIC RELIEF SYSTEM DETAILS**

Arcadis Project No. B0036728.0001.00003	
Date NOVEMBER 2017	<b>C-505</b>
Arcadis One Lincoln Center 110 West Fayette Street, Suite 300 Syracuse, NY 13202 Tel. 315.446.9120	

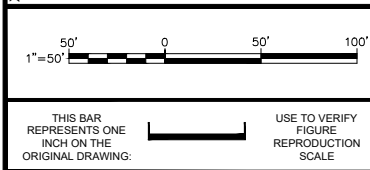

3	8/13/2021	ADD NEW CLOSURE WALL, REVISED BULKHEAD ALIGNMENT TO REFLECT AS-BUILT CONDITIONS, AND REVISED FINAL GRADE CONTOURS	MSG	MJL
2	4/13/2020	REVISED BULKHEAD TERMINATION AT TUNNEL SHAFT	DGN	MJL
1	1/10/2020	REVISED PIPING ALIGNMENT AT MANHOLES AND ADDED ADDITIONAL MANHOLE	DGN	MJL
No.	Date	Revisions	By	Ck
THIS DRAWING IS THE PROPERTY OF THE ARCADIS ENTITY IDENTIFIED IN THE TITLE BLOCK AND MAY NOT BE REUSED OR ALTERED IN WHOLE OR IN PART WITHOUT THE EXPRESS WRITTEN CONSENT OF THE SAME.				

Professional Engineer's Name	
<b>TERRY W. YOUNG</b>	
Professional Engineer's No.	
074847	
State	Date Signed
NY	2/4/2019
Designed by	Drawn by
RPK	JLH



ARCADIS OF NEW YORK, INC.  
NO ALTERATIONS PERMITTED HEREON EXCEPT AS  
PROVIDED UNDER SECTION 7209 SUBDIVISION 2 OF THE  
NEW YORK STATE EDUCATION LAW

NATIONAL GRID USA • BROOKLYN, NEW YORK  
FORMER CITIZENS GAS WORKS MANUFACTURED GAS PLANT SITE  
CARROLL GARDENS/PUBLIC PLACE  
BOROUGH OF BROOKLYN, KINGS COUNTY, NEW YORK  
SITE REMEDIATION

**SITE BULKHEAD BARRIER  
WALL PLAN**


Arcadis Project No. B0036728.0001.00003	<b>S-103A</b>
Date FEBRUARY 2019	
Arcadis One Lincoln Center 110 West Fayette Street, Suite 300 Syracuse, NY 13202 Tel. 315.446.9120	

C:\Users\jharris\ACD\Docs\Arcadis\AUS-NATIONAL GRID-FORMER CITIZENS MGP-BROOKLYN New York\Project Files\2021\01-In Progress\01-DWG\CONTRACT-BULKHEAD-ALTERNATE.dwg LAYOUT: S-105A SAVED: 8/16/2021 4:19 PM PLOTSTYLETABLE: --- PLOTTED: 8/17/2021 1:34 PM BY: HARRIS, JESS

BULKHEAD ANCHOR SCHEDULE					
ANCHOR NO.	REQUIRED SECTION	ANCHOR OFFSET (FEET)	MIN. SHEET PILE TIP EL. (FEET NAVD88)	TIE ROD/WALE EL. (FEET NAVD88)	PILE CUT-OFF EL. (FEET NAVD88)
A-01 TO A-03	AZ 36-700N	45.5	-27.0	5.0	7.0
EVEN ANCHORS FROM A-04 TO A-16	AZ 36-700N	48.0	-27.0	5.0	7.0
ODD ANCHORS FROM A-05 TO A-15	AZ 36-700N	45.5	-27.0	5.0	7.0
A-17, A-19, A-21, AND A-23	AZ 36-700N	48.0	-27.0	5.0	7.0
A-18, A-20, A-22, AND A-24	AZ 36-700N	45.5	-27.0	5.0	7.0
A-25	AZ 36-700N	48.0	-18.0	5.0	7.0

NOTE:


- EXISTING GAS TRANSMISSION TUNNEL AND SHAFT TO BE FILLED AND MODIFIED BY OTHERS (NOT PART OF THIS CONTRACT) TO ACCOMMODATE FINAL SITE GRADES. DO NOT INITIATE BULKHEAD DEMOLITION OR PILE DRIVING OPERATIONS UNTIL TUNNEL/SHAFT FILLING AND MODIFICATION ACTIVITIES ARE COMPLETE. OWNER'S GAS DEPARTMENT WILL CONFIRM STABILITY OF GAS TRANSMISSION TUNNEL AND SHAFT BASED ON POST-REMEDATION DESIGN LOADS PURSUANT TO SEPTEMBER 14, 2017 MEETING.

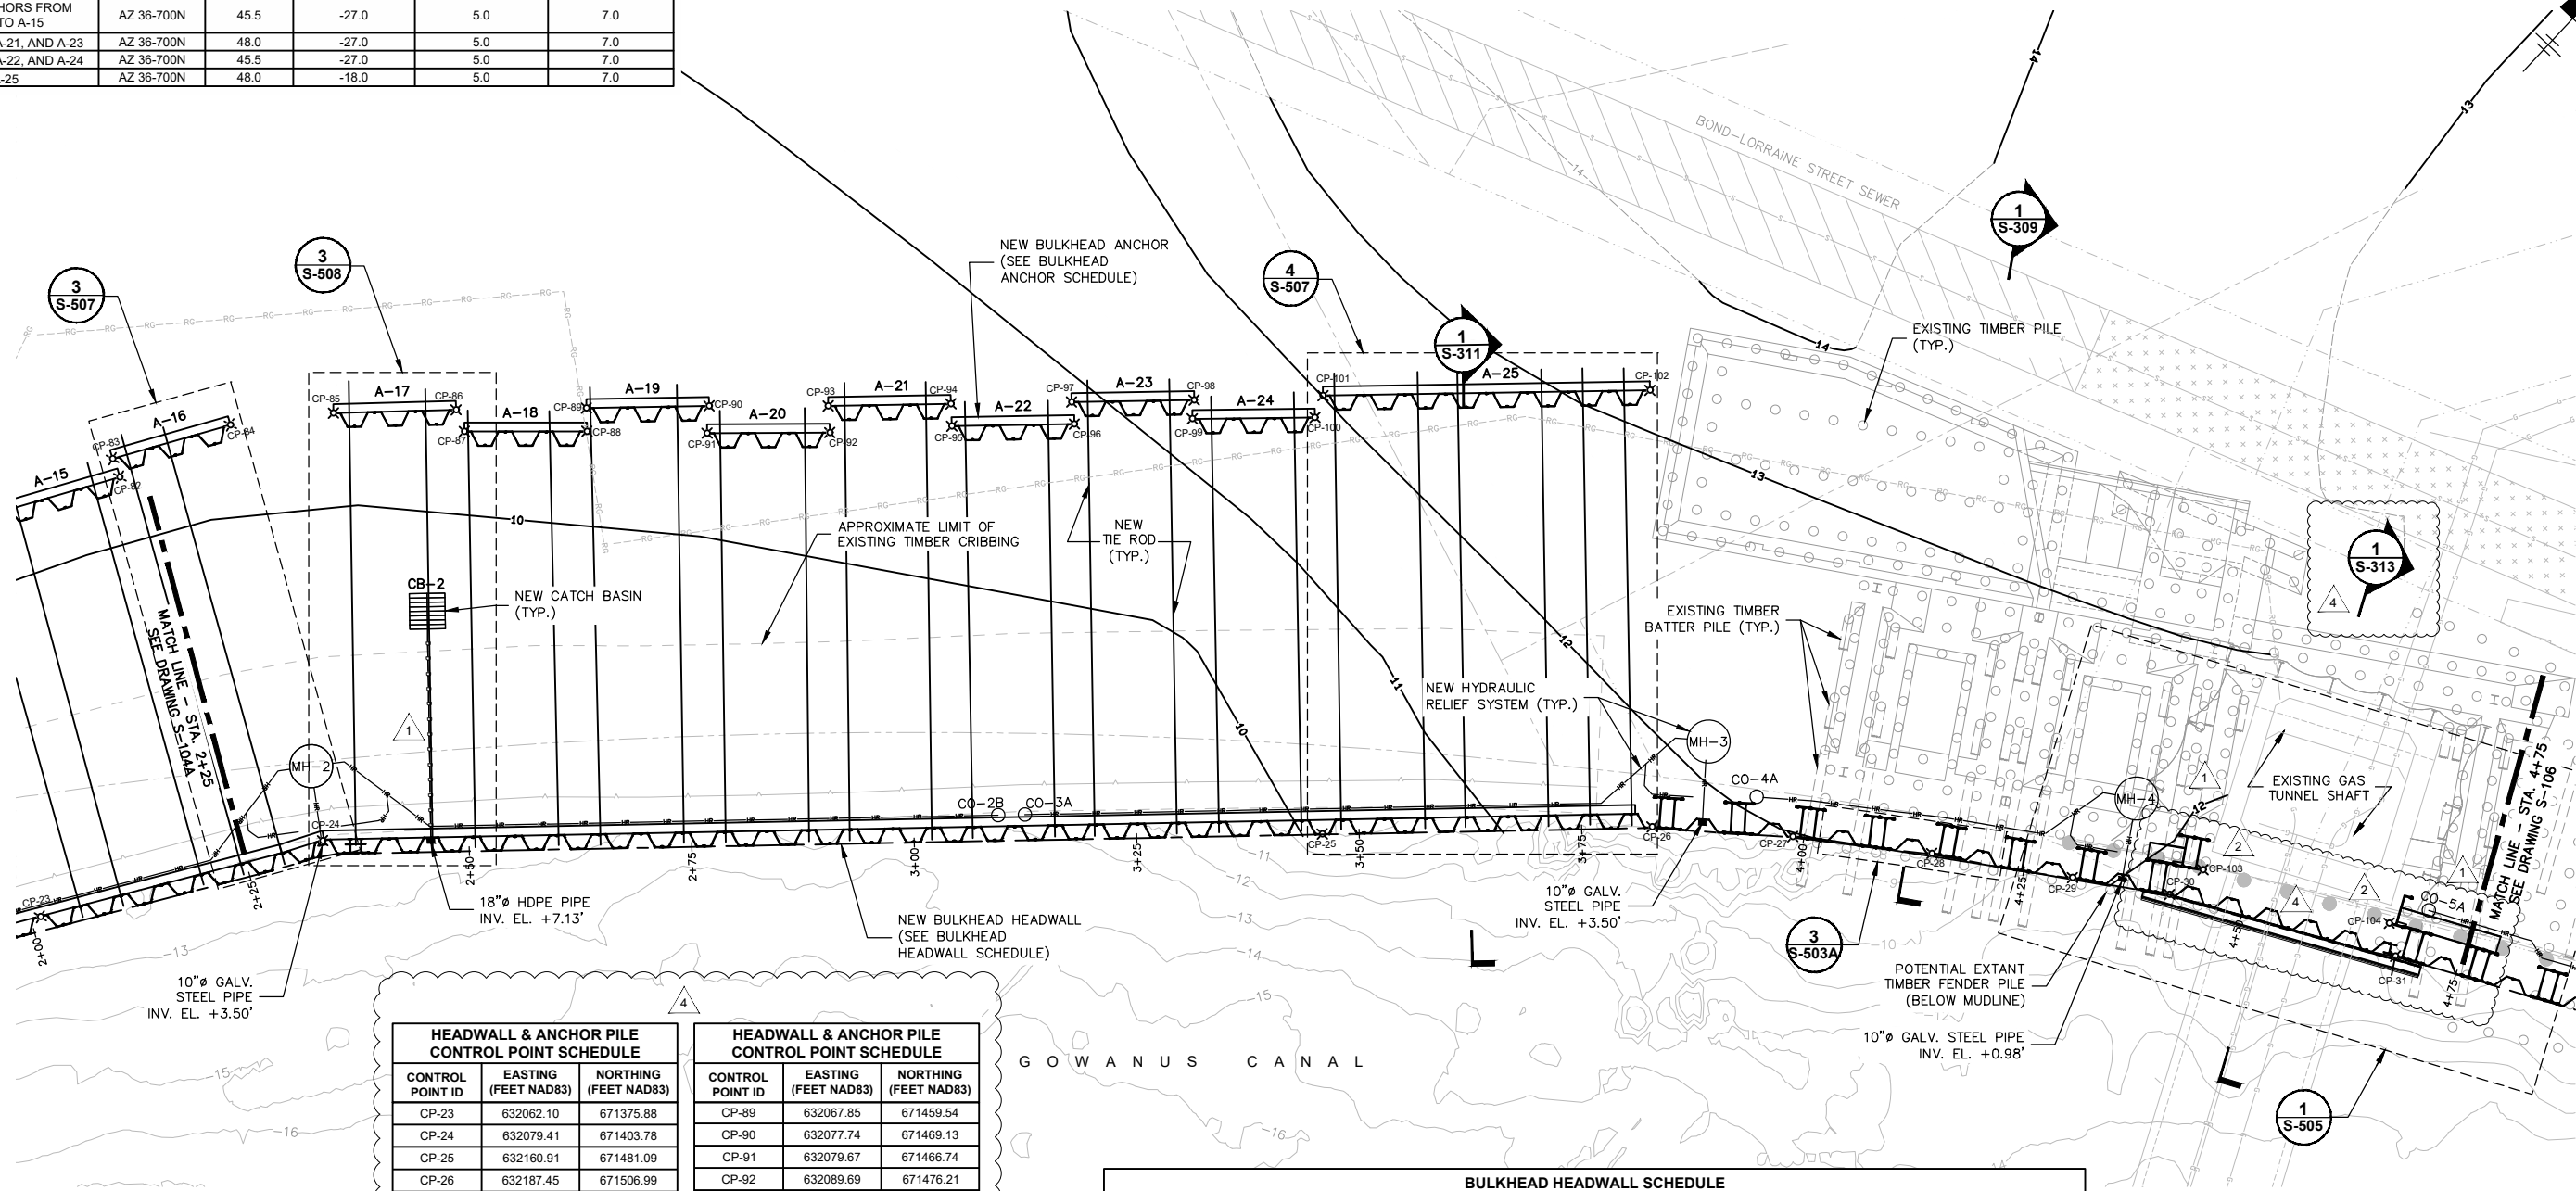

HEADWALL & ANCHOR PILE CONTROL POINT SCHEDULE		
CONTROL POINT ID	EASTING (FEET NAD83)	NORTHING (FEET NAD83)
CP-23	632062.10	671375.88
CP-24	632079.41	671403.78
CP-25	632160.91	671481.09
CP-26	632187.45	671506.99
CP-27	632199.73	671516.98
CP-28	632212.43	671526.28
CP-29	632225.82	671535.08
CP-30	632235.07	671541.14
CP-31	632258.34	671553.44
CP-82	632034.87	671418.05
CP-83	632032.85	671419.00
CP-84	632039.92	671430.83
CP-85	632047.47	671439.71
CP-86	632057.29	671449.38
CP-87	632059.62	671448.25
CP-88	632069.67	671457.67


HEADWALL & ANCHOR PILE CONTROL POINT SCHEDULE		
CONTROL POINT ID	EASTING (FEET NAD83)	NORTHING (FEET NAD83)
CP-89	632067.85	671459.54
CP-90	632077.74	671469.13
CP-91	632079.67	671466.74
CP-92	632089.69	671476.21
CP-93	632087.52	671478.28
CP-94	632097.43	671487.86
CP-95	632099.20	671486.10
CP-96	632109.11	671495.68
CP-97	632107.18	671497.28
CP-98	632117.09	671506.85
CP-99	632118.39	671505.17
CP-100	632128.35	671514.69
CP-101	632127.32	671517.11
CP-102	632153.75	671542.64
CP-103	632235.94	671545.75
CP-104	632255.30	671555.65

BULKHEAD HEADWALL SCHEDULE							
WALL ALIGNMENT		LENGTH OF WALL (LF)	WALL TYPE	REQUIRED SECTION	MIN. SHEET PILE TIP EL. (FEET NAVD88)	MIN. KING PILE TIP EL. (FEET NAVD88)	PILE CUT-OFF EL. (FEET NAVD88)
FROM	TO						
CP-20	CP-25	345.9	ANCHORED TIEBACK WALL	AZ 42-700N	-43.0	--	10.0
CP-25	CP-26	37.1	ANCHORED TIEBACK WALL	AZ 46-700N	-43.0	--	12.0
CP-26	CP-27	15.8	COMBINATION WALL	HZ 1180M C M-26 / AZ 19-700	-40.0	-83.0	12.0
CP-27	CP-30	42.8	COMBINATION WALL	HZ 1180M D M-26 / AZ 19-700	-40.0	-83.0	12.0
CP-30	CP-31	26.3	SHEET PILE WALL	AZ 26-700	-21.5	--	0.0
CP-31	CP-38	168.5	COMBINATION WALL	HZ 1180M D M-26 / AZ 19-700	-40.0	-83.0	12.0

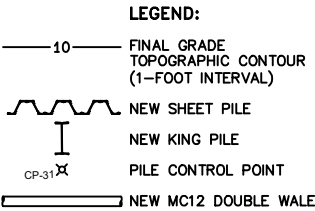

IMAGES: Arcadis Logo BW\_2021.PNG  
LAB FILE 11.30.17.dwg  
LAB FILE 24.19.17.dwg  
TWT FILE 11.30.17.dwg

REFERENCES: 36728X00 Tunnel revisions  
36728X01 Tunnel revisions  
36728X02 Tunnel revisions  
36728X03 Tunnel revisions  
36728X04 Tunnel revisions  
36728X05 Tunnel revisions  
36728X06 Tunnel revisions  
36728X07 Tunnel revisions  
36728X08 Tunnel revisions  
36728X09 Tunnel revisions  
36728X10 Tunnel revisions

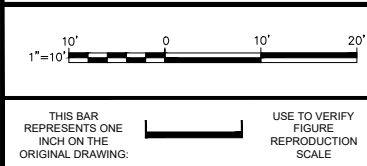

4	8/13/2021	ADDED NEW CLOSURE WALL AND REVISED BULKHEAD ALIGNMENT TO REFLECT AS-BUILT CONDITIONS	MSG	MJB
3	7/22/2020	REVISED HEADWALL TRANSITION AT CP-38	DGN	MJB
2	4/13/2020	REVISED BULKHEAD TERMINATION AT TUNNEL SHAFT	DGN	MJB
1	1/10/2020	REVISED PIPING ALIGNMENT AT MANHOLES, ADDED ADDITIONAL MANHOLE, AND REVISED STRUCTURE	DGN	MJB
LABELS				
No.	Date	Revisions	By	Ckd
THIS DRAWING IS THE PROPERTY OF THE ARCADIS ENTITY IDENTIFIED IN THE TITLE BLOCK AND MAY NOT BE REUSED OR ALTERED IN WHOLE OR IN PART WITHOUT THE EXPRESS WRITTEN PERMISSION OF SAME.				

Professional Engineer's Name		
TERRY W. YOUNG		
Professional Engineer's No.		
074847		
State	Date Signed	Project Mgr.
NY	2/4/2019	MJB
Designed by	Drawn by	Checked by
RPK	JLH	APC



**ARCADIS** Design & Consultancy for natural and built assets

ARCADIS OF NEW YORK, INC.


NO ALTERATIONS PERMITTED HEREON EXCEPT AS PROVIDED UNDER SECTION 7209 SUBDIVISION 2 OF THE NEW YORK STATE EDUCATION LAW

NATIONAL GRID USA • BROOKLYN, NEW YORK  
FORMER CITIZENS GAS WORKS MANUFACTURED GAS PLANT SITE  
CARROLL GARDENS/PUBLIC PLACE  
BOROUGH OF BROOKLYN, KINGS COUNTY, NEW YORK  
SITE REMEDIATION

**BULKHEAD BARRIER WALL PLAN**  
**STA. 2+25 TO STA. 4+75**

Arcadis Project No. 80036728.0001.00003	
Date	FEBRUARY 2019
Arcadis One Lincoln Center 110 West Fayette Street, Suite 300 Syracuse, NY 13202 Tel. 315.446.9120	

S-105A

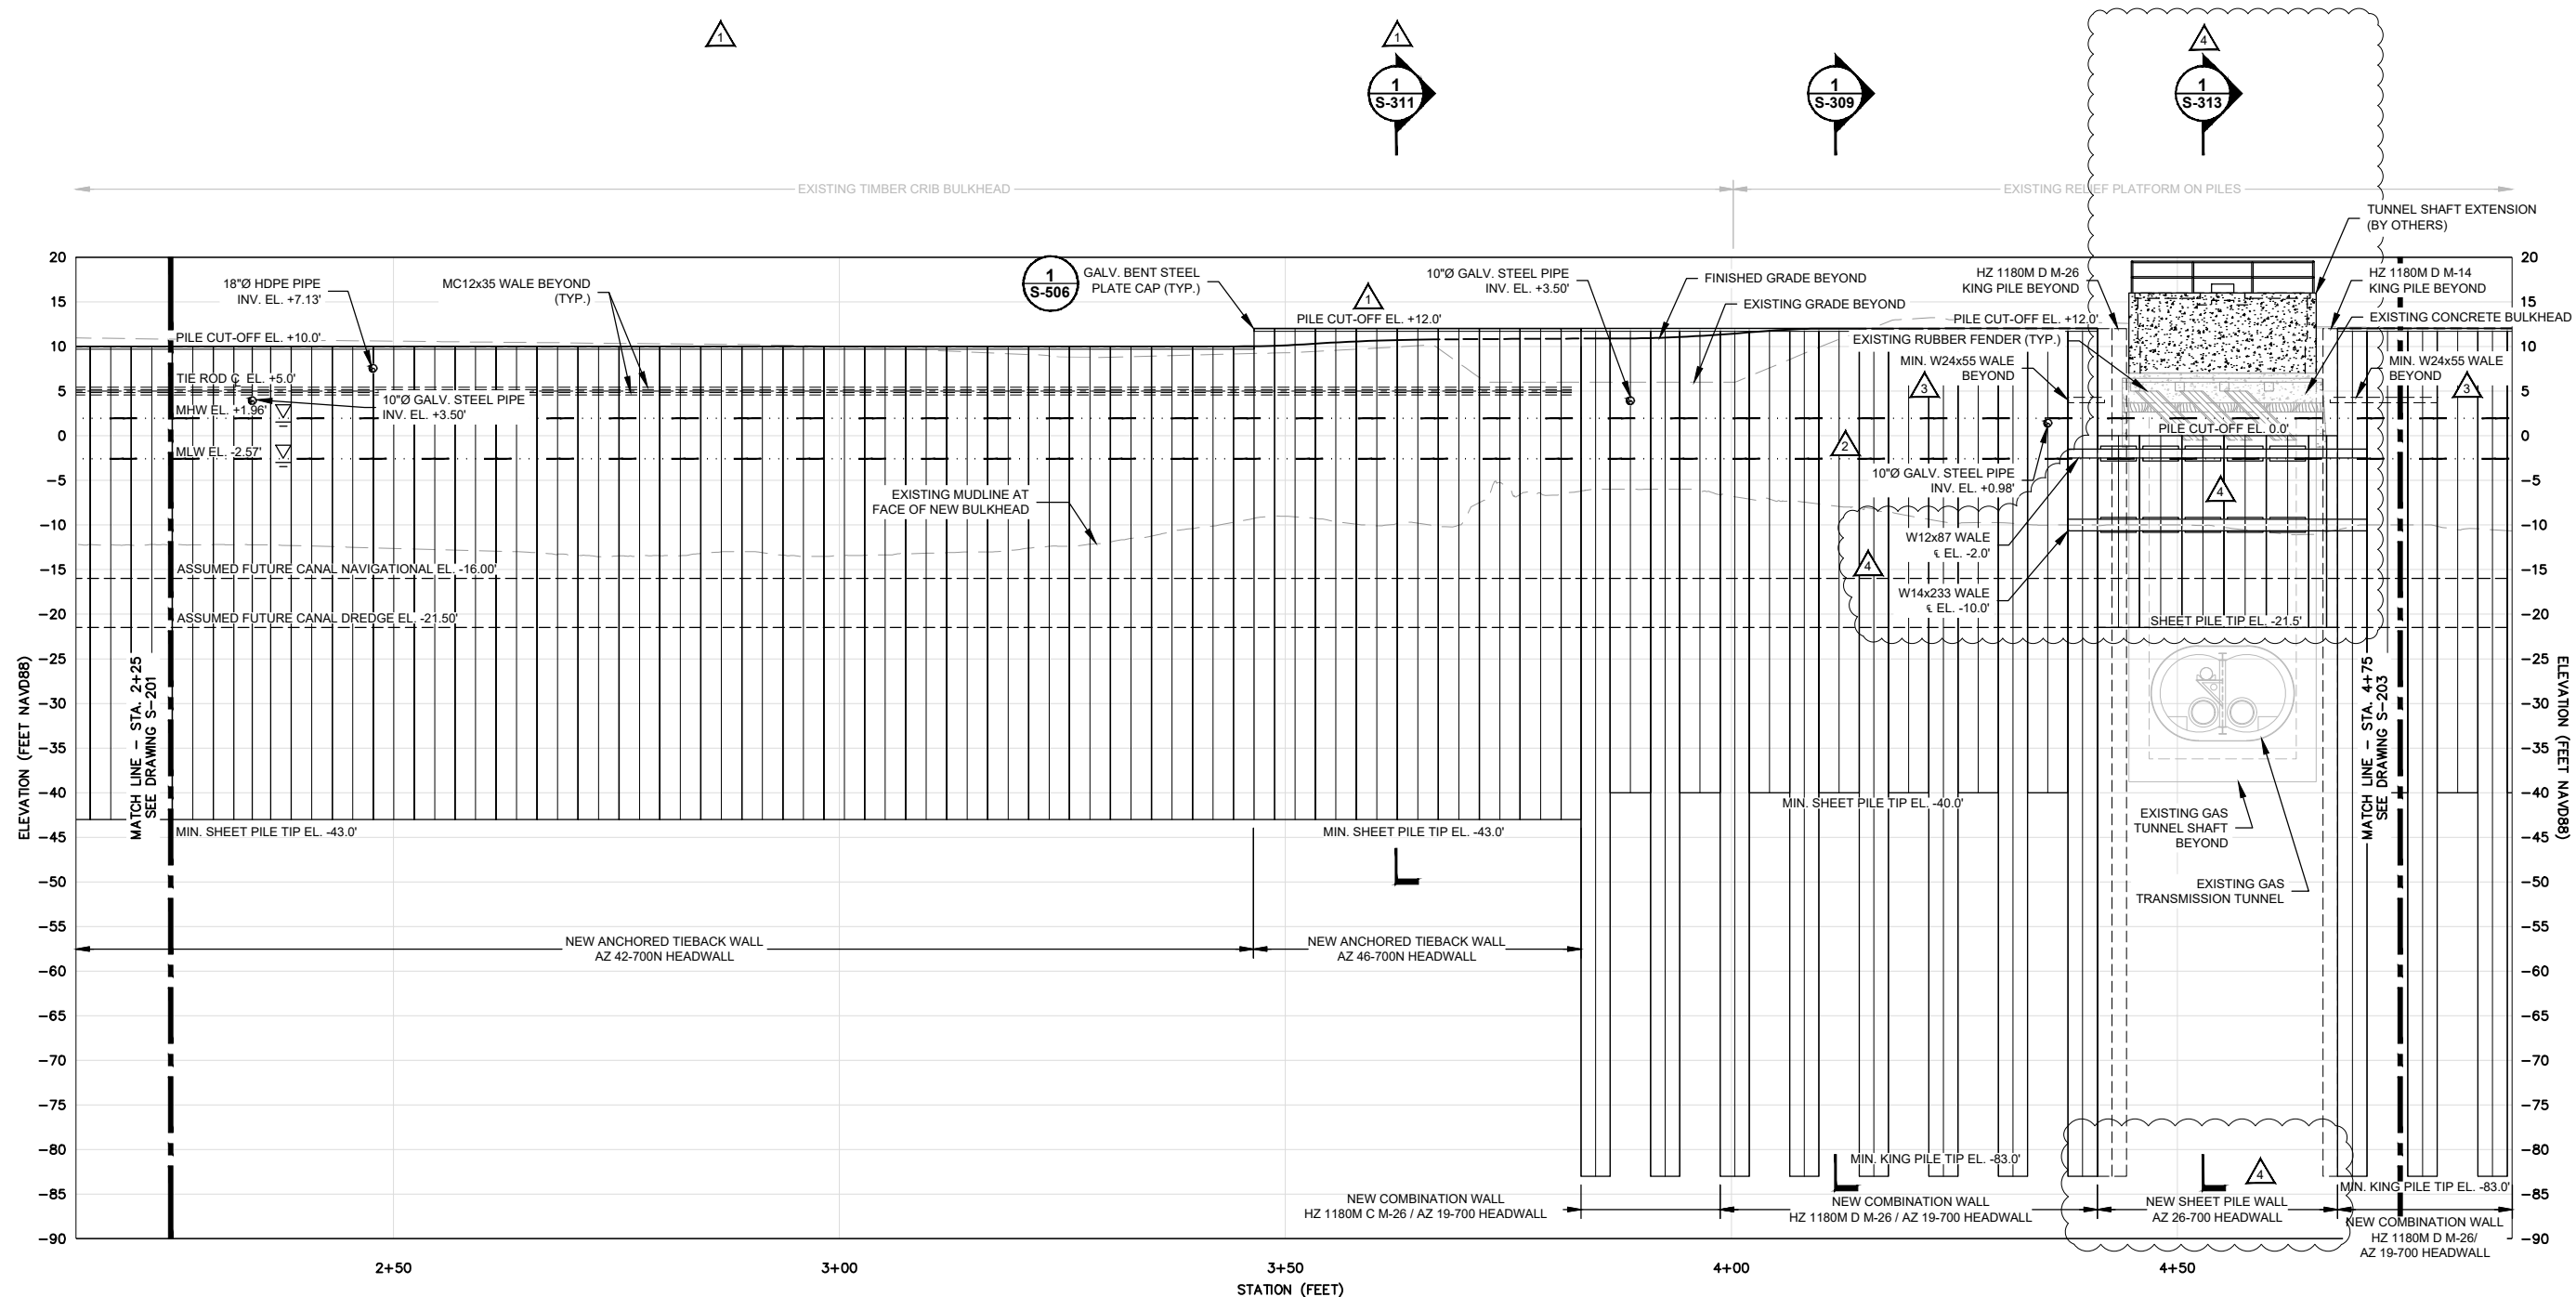

4	8/13/2021	ADDED NEW CLOSURE WALL AND REVISED PILE LOCATIONS TO REFLECT AS-BUILT CONDITIONS	MSG	MJB
3	11/13/2020	ADDED NEW WALES AT BULKHEAD TERMINATIONS AT TUNNEL SHAFT	LAB	JRG
2	1/10/2020	ADDED NEW PIPE PENETRATION	DGN	MJB
1	2/4/2019	DELETED DUPLICATE SECTION, ADDED NEW SECTION, & REVISED PILE CUT-OFF EL. FROM CP-25 TO CP-26	RPK	MJB
No.	Date	Revisions	By	Ckd
THIS DRAWING IS THE PROPERTY OF THE ARCADIS ENTITY IDENTIFIED IN THE TITLE BLOCK AND MAY NOT BE REUSED OR ALTERED IN WHOLE OR IN PART WITHOUT THE EXPRESS WRITTEN PERMISSION OF SAME.				





**Design & Consultancy  
for natural and  
built assets**

Arcadis Project No. B0036728.0001.00003
Date NOVEMBER 2017
Arcadis One Lincoln Center 110 West Fayette Street, Suite 300 Syracuse, NY 13202 Tel. 315.446.9120


**S-202**



C:\Users\jharris\ACD\Docs\Arcadis\AUS-NATIONAL GRID-FORMER CITIZENS MGP-BROOKLYN New York\Project Files\2021\01-In Progress\01-DWG\CONTRACT-S-313-BH BW SECT.dwg LAYOUT: S-313 - PLOTTED: 8/16/2021 2:00 PM BY: HARRIS, JESS

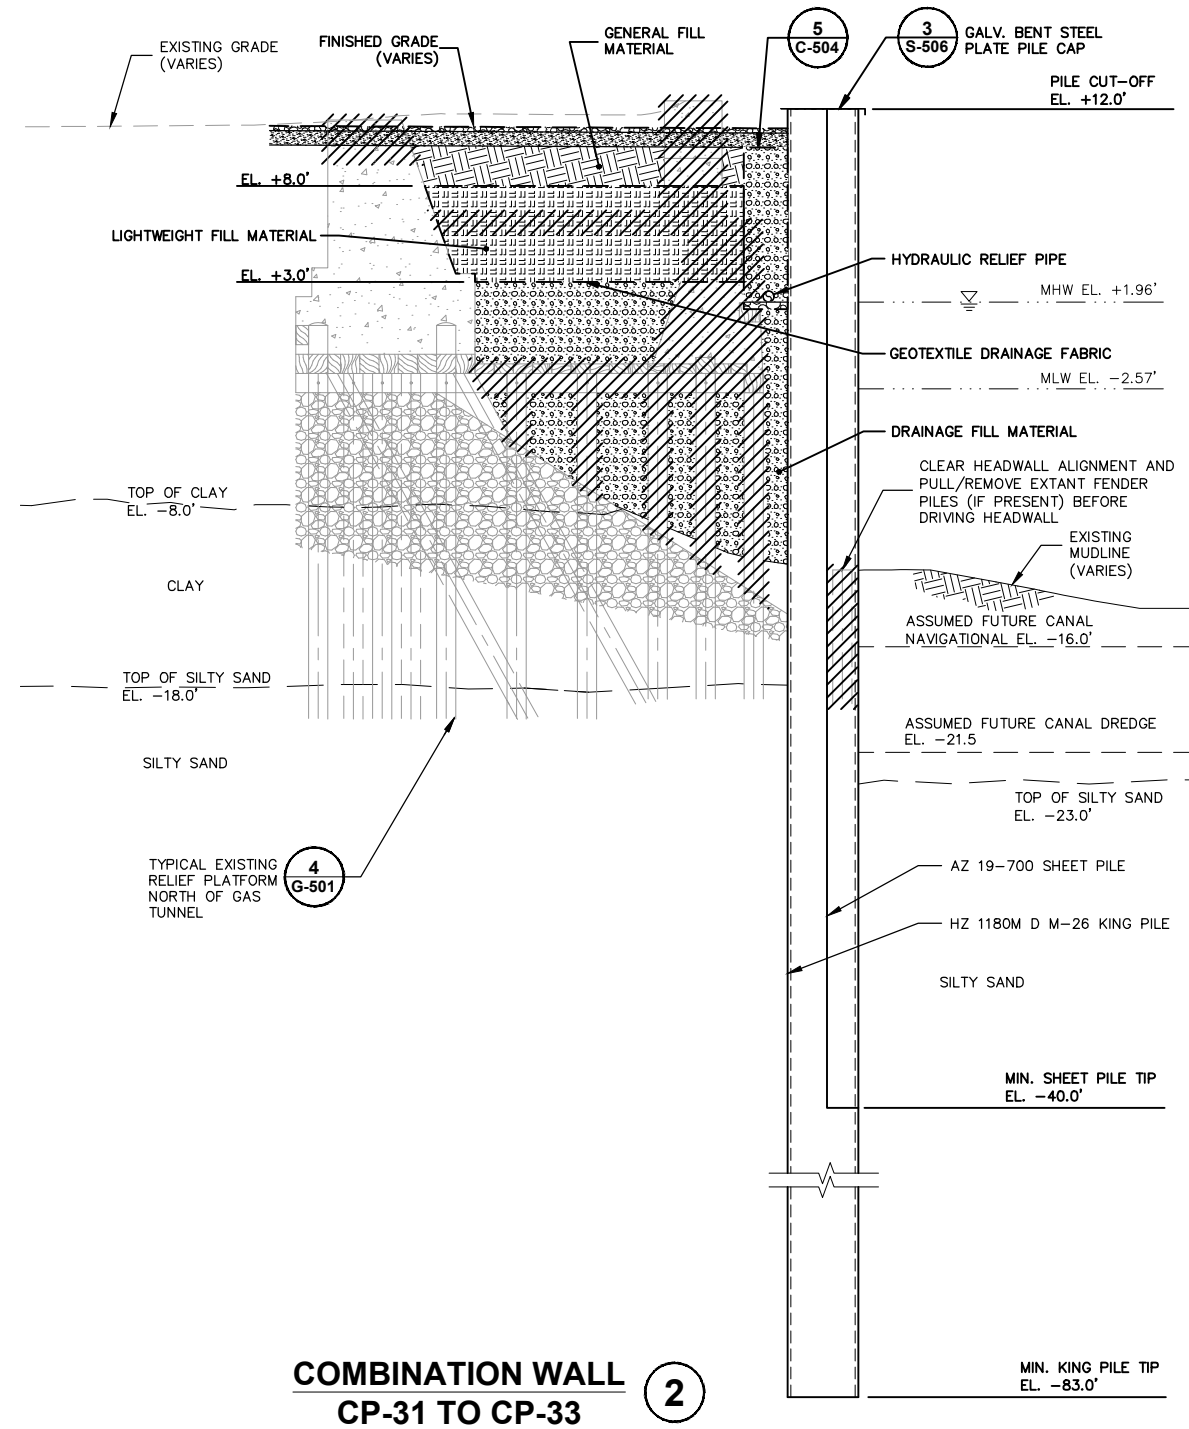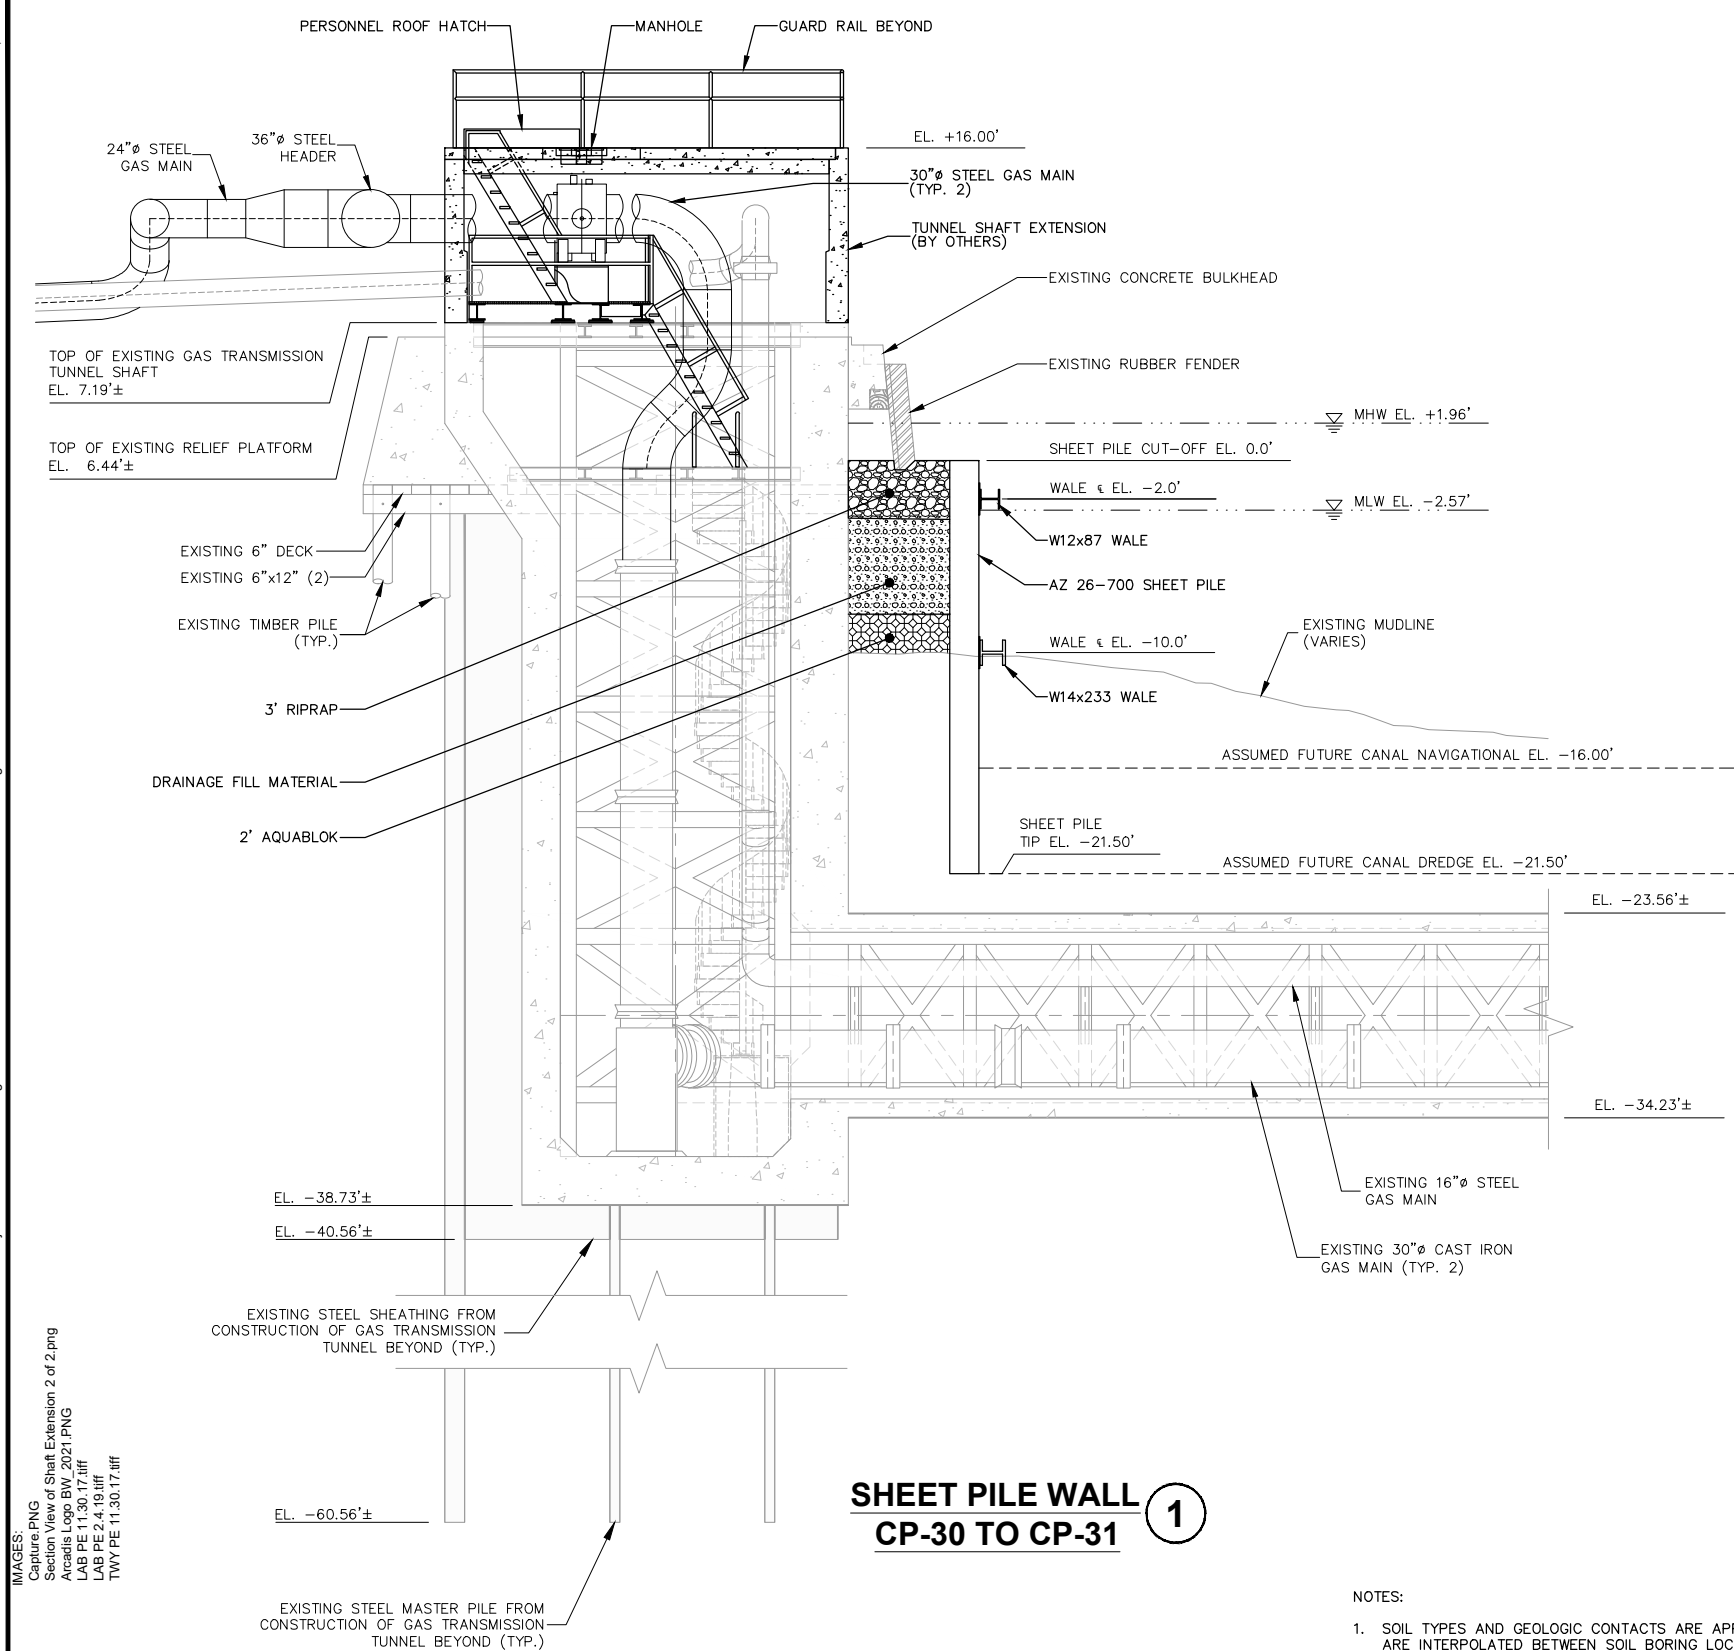

- NOTES:
1. SOIL TYPES AND GEOLOGIC CONTACTS ARE APPROXIMATE AND ARE INTERPOLATED BETWEEN SOIL BORING LOCATIONS. ACTUAL SUBSURFACE CONDITIONS MAY BE DIFFERENT THAN THOSE SHOWN OR INDICATED.
  2. ADDITIONAL STRUCTURES AND UNDERGROUND FACILITIES MAY BE PRESENT THAT ARE NOT SHOWN OR INDICATED.

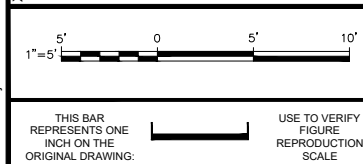


No.	Date	Revisions	By	Ckd

Professional Engineer's Name <b>TERRY W. YOUNG</b>		
Professional Engineer's No. 074847		
State NY	Date Signed 8/13/2021	Project Mgr. MJB
Designed by MSG/LAB	Drawn by JLH	Checked by MJB



NATIONAL GRID USA • BROOKLYN, NEW YORK FORMER CITIZENS GAS WORKS MANUFACTURED GAS PLANT SITE CARROLL GARDENS/PUBLIC PLACE BOROUGH OF BROOKLYN, KINGS COUNTY, NEW YORK SITE REMEDIATION		Arcadis Project No. 80036728.0001.00003	S-313
		Date AUGUST 2021	
		Arcadis One Lincoln Center 110 West Fayette Street, Suite 300 Syracuse, NY 13202 Tel. 315.446.9120	

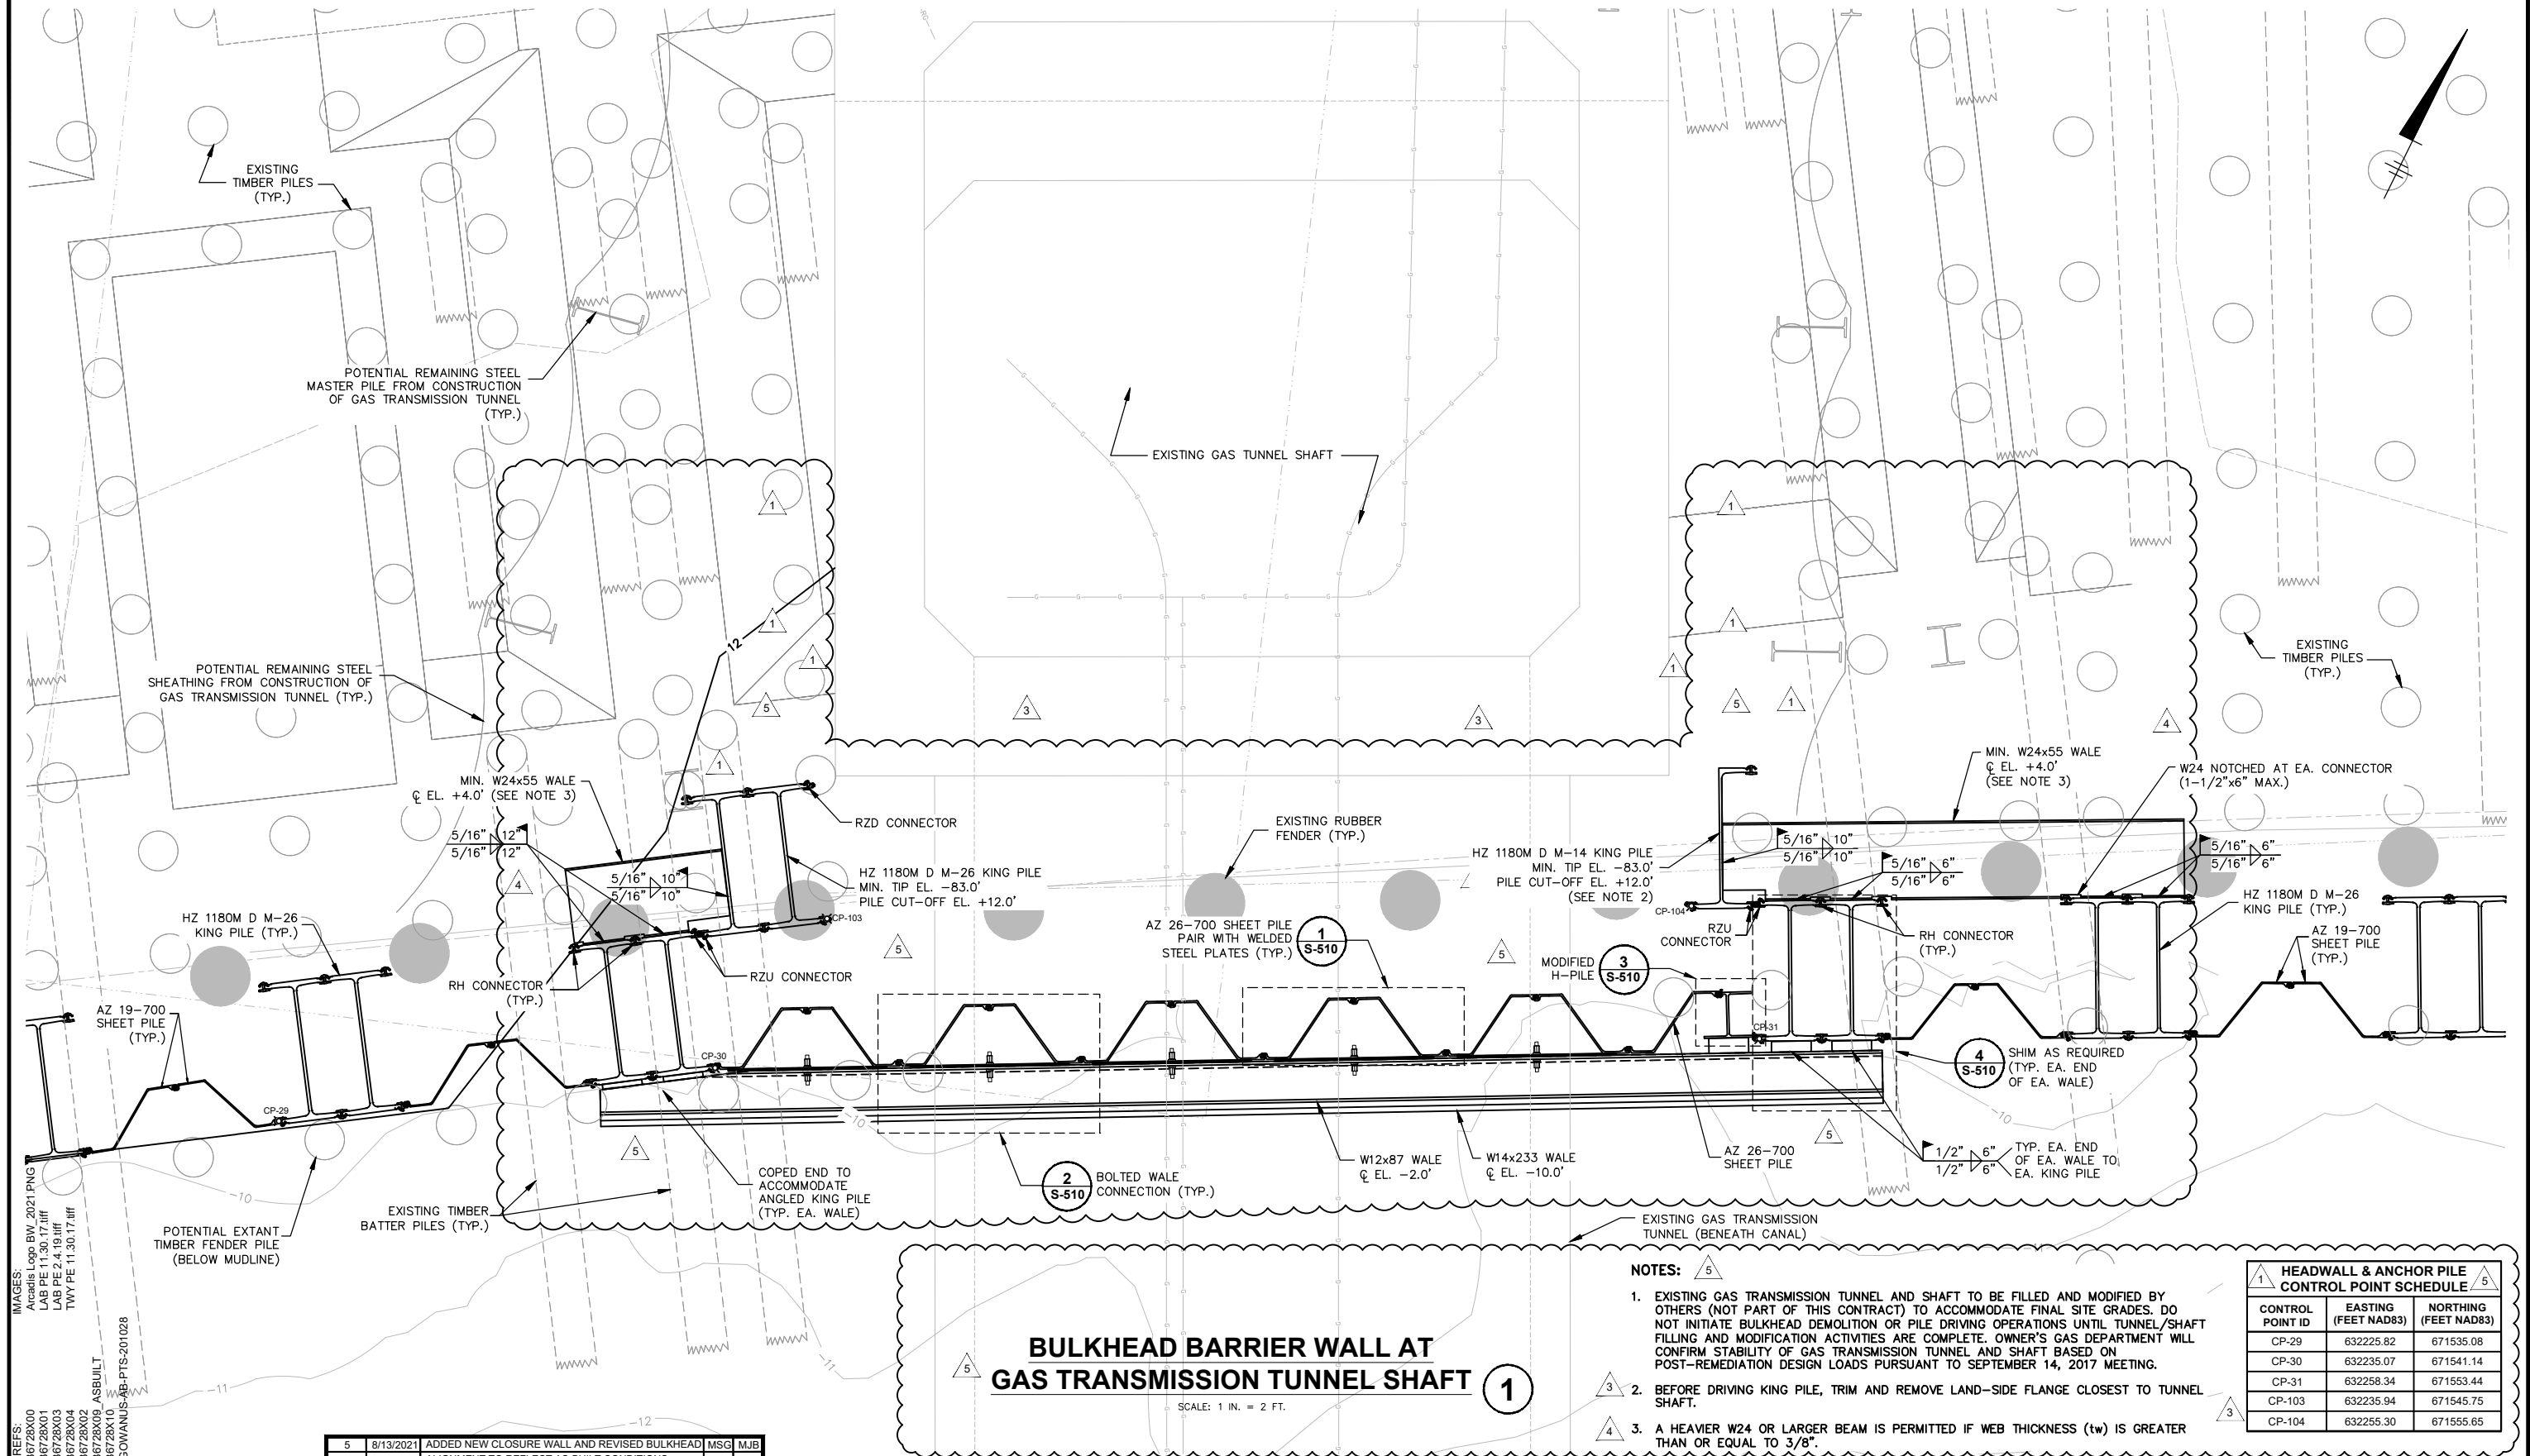

HEADWALL & ANCHOR PILE CONTROL POINT SCHEDULE		
CONTROL POINT ID	EASTING (FEET NAD83)	NORTHING (FEET NAD83)
CP-29	632225.82	671535.08
CP-30	632235.07	671541.14
CP-31	632258.34	671553.44
CP-103	632235.94	671545.75
CP-104	632255.30	671555.65

## BULKHEAD BARRIER WALL AT GAS TRANSMISSION TUNNEL SHAFT

SCALE: 1 IN. = 2 FT.

- NOTES:** 5
1. EXISTING GAS TRANSMISSION TUNNEL AND SHAFT TO BE FILLED AND MODIFIED BY OTHERS (NOT PART OF THIS CONTRACT) TO ACCOMMODATE FINAL SITE GRADES. DO NOT INITIATE BULKHEAD DEMOLITION OR PILE DRIVING OPERATIONS UNTIL TUNNEL/SHAFT FILLING AND MODIFICATION ACTIVITIES ARE COMPLETE. OWNER'S GAS DEPARTMENT WILL CONFIRM STABILITY OF GAS TRANSMISSION TUNNEL AND SHAFT BASED ON POST-REMEDIAL DESIGN LOADS PURSUANT TO SEPTEMBER 14, 2017 MEETING.
  2. BEFORE DRIVING KING PILE, TRIM AND REMOVE LAND-SIDE FLANGE CLOSEST TO TUNNEL SHAFT.
  3. A HEAVIER W24 OR LARGER BEAM IS PERMITTED IF WEB THICKNESS ( $t_w$ ) IS GREATER THAN OR EQUAL TO  $3/8"$ .

5	8/13/2021	ADDED NEW CLOSURE WALL AND REVISED BULKHEAD ALIGNMENT TO REFLECT AS-BUILT CONDITIONS	MSG	MJB
4	11/13/2020	ADDED NEW WALES AT BULKHEAD TERMINATIONS AT TUNNEL SHAFT	LAB	JRG
3	4/13/2020	REVISED BULKHEAD TERMINATION AT TUNNEL SHAFT	DGN	MJB
2	6/19/2019	REVISED KING PILE SECTION LABEL IN RESPONSE TO RFI NO. 1	AJB	MJB
1	3/8/2019	REVISED CONTROL POINT IDS AND COORDINATES	RPK	MJB
No.	Date	Revisions	By	Ckd

THIS DRAWING IS THE PROPERTY OF THE ARCADIS ENTITY IDENTIFIED IN THE TITLE BLOCK AND MAY NOT BE REUSED OR ALTERED IN WHOLE OR IN PART WITHOUT THE EXPRESSED WRITTEN PERMISSION OF THE ORIGINAL OWNER.

Professional Engineer's Name	
<b>TERRY W. YOUNG</b>	
Professional Engineer's No.	
074847	
State	Date Signed
NY	11/30/2017
Designed by	Drawn by
RPK	JLH



ARCADIS OF NEW YORK, INC.

NO ALTERATIONS PERMITTED HEREON EXCEPT AS  
PROVIDED UNDER SECTION 7209 SUBDIVISION 2 OF THE  
NEW YORK STATE EDUCATION LAW

NATIONAL GRID USA • BROOKLYN, NEW YORK  
FORMER CITIZENS GAS WORKS MANUFACTURED GAS PLANT SITE  
CARROLL GARDENS/PUBLIC PLACE  
BOROUGH OF BROOKLYN, KINGS COUNTY, NEW YORK  
**SITE REMEDIATION**

## BULKHEAD BARRIER WALL DETAILS

Arcadis Project No.  
B0036728.0001.00003

Date  
NOVEMBER 2017



Arcadis  
One Lincoln Center  
110 West Fayette Street, Suite 300  
Syracuse, NY 13202  
Tel. 315.446.9120

**S-505**




C:\Users\jrharris\ACD\docs\Arcadis\AUS-NATIONAL GRID-FORMER CITIZENS MGP-BROOKLYN New York\Project Files\2021\01-10-2021\DWG\CONTRACT-S-510-BH BARRIER WALL DET.dwg LAYOUT: S-510 SAVED: 8/16/2021 1:50 PM PLOTTED: 8/16/2021 3:14 PM BY: HARRIS, JESS



IMAGES:  
Arcadis Logo BW\_2021.PNG  
LAB FE 11.30.17.dwg  
LAB FE 2.4.19.dwg  
TWY FE 11.30.17.dwg  
XREFS:  
36728X00

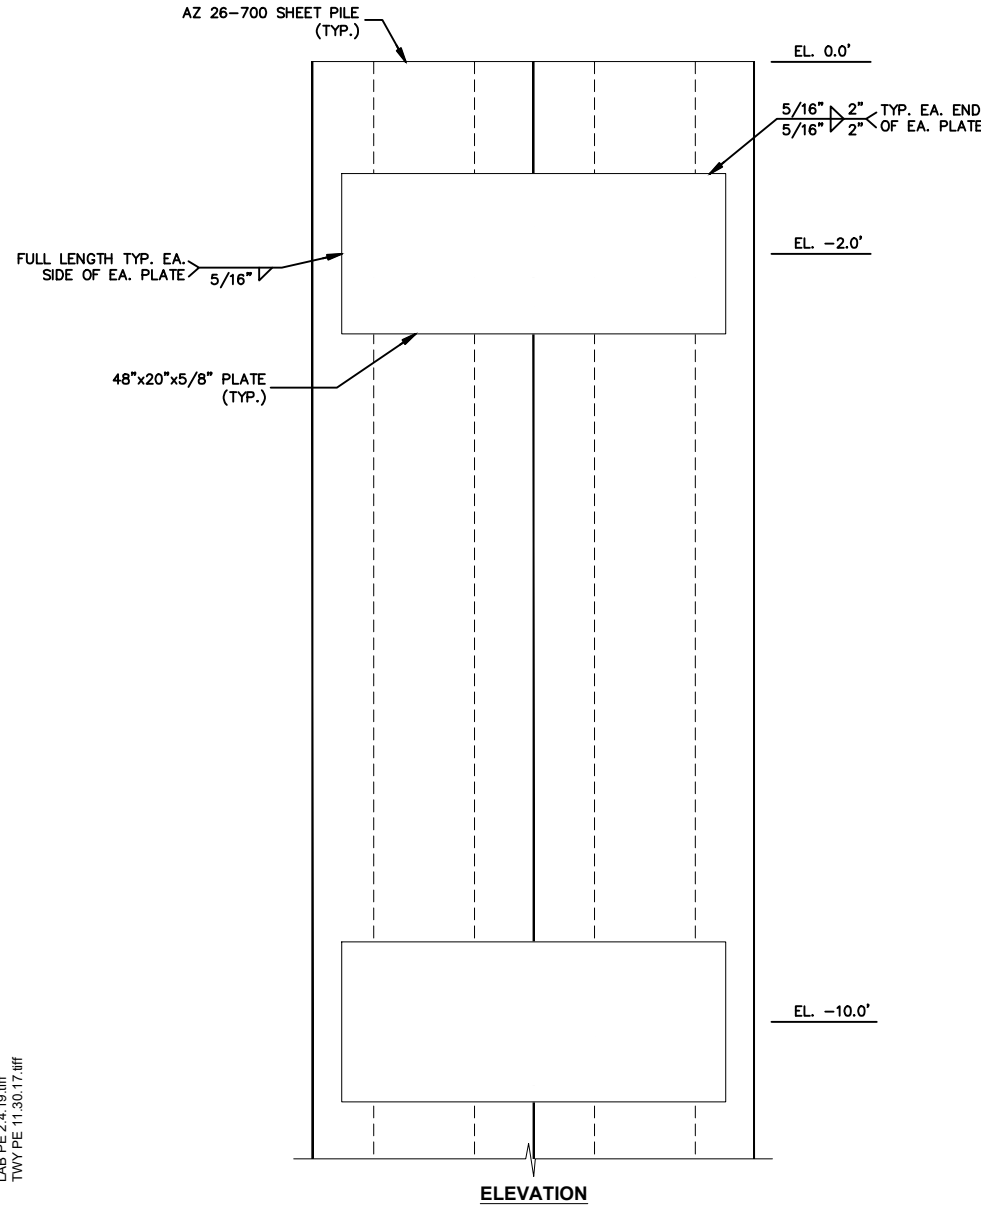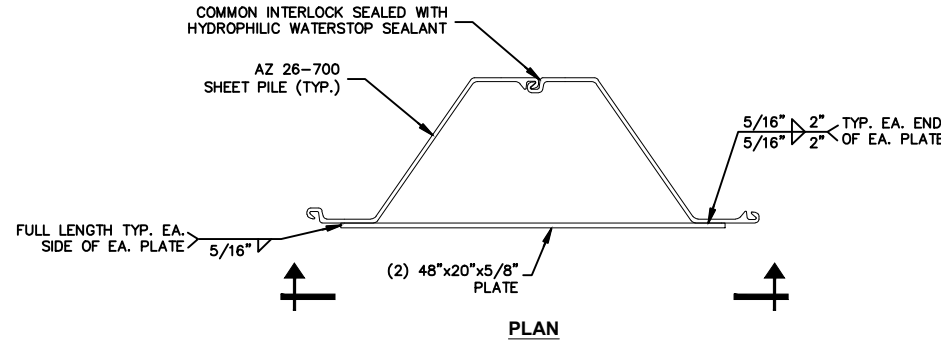


**AZ 26-700 SHEET PILE PAIR  
WITH WELDED STEEL PLATES**

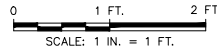


1

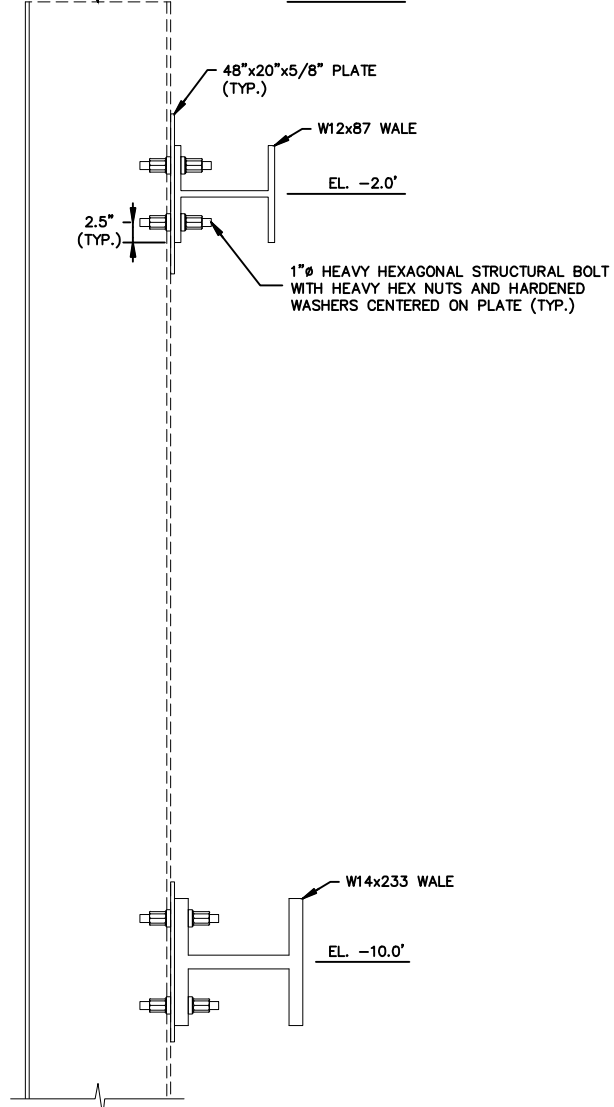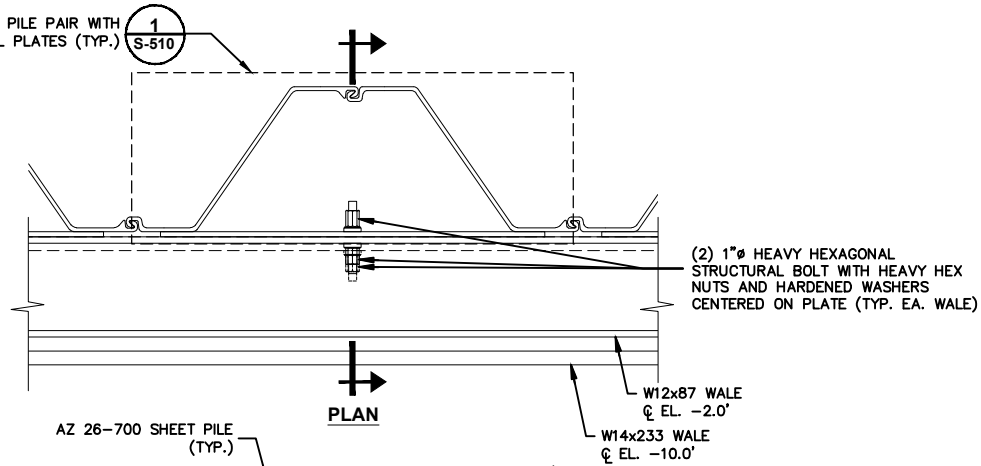

**BOLTED WALE CONNECTION**

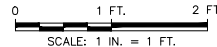

2

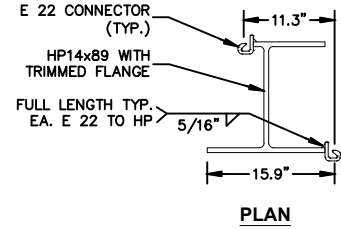


NOTE:

1. FIELD-VERIFY ALL DIMENSIONS, INCLUDING DISTANCE BETWEEN INTERLOCKS OF KING PILE AND FINAL SHEET PILE, BEFORE TRIMMING FLANGE AND FABRICATING PILE.


**MODIFIED H-PILE**



3

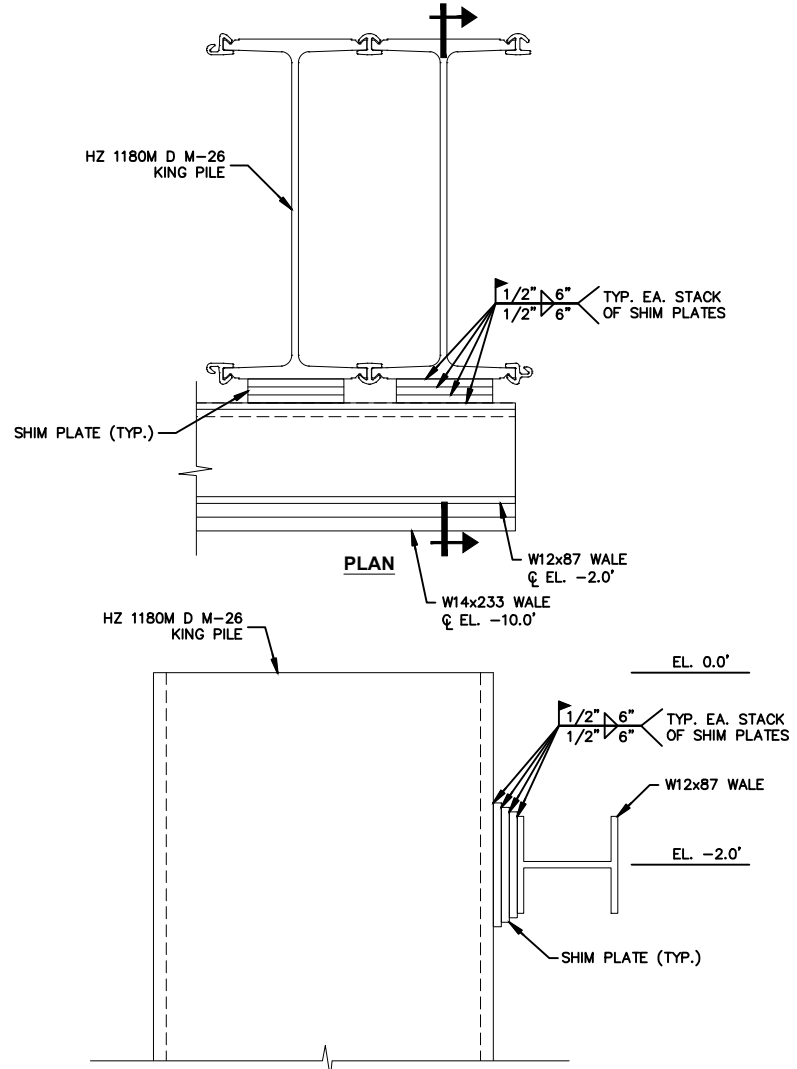

**TYPICAL SHIM DETAIL FOR  
WELDED WALE CONNECTIONS**

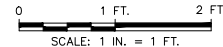

4

0 1 FT. 2 FT.  
SCALE: 1 IN. = 1 FT.

THIS BAR REPRESENTS ONE INCH ON THE ORIGINAL DRAWING.

USE TO VERIFY FIGURE REPRODUCTION SCALE

No.	Date	Revisions	By	Ckd

THIS DRAWING IS THE PROPERTY OF THE ARCADIS ENTITY IDENTIFIED IN THE TITLE BLOCK AND MAY NOT BE REUSED OR ALTERED IN WHOLE OR IN PART WITHOUT THE EXPRESS WRITTEN PERMISSION OF SAME.

Professional Engineer's Name <b>LISA A. BOWE</b>			
Professional Engineer's No. 086254			
State NY	Date Signed 8/13/2021	Project Mgr. MJB	
Designed by LAB	Drawn by JLH	Checked by MJB	



**ARCADIS** Design & Consultancy for natural and built assets

ARCADIS OF NEW YORK, INC.

NO ALTERATIONS PERMITTED HEREON EXCEPT AS PROVIDED UNDER SECTION 7209 SUBDIVISION 2 OF THE NEW YORK STATE EDUCATION LAW

NATIONAL GRID USA • BROOKLYN, NEW YORK  
FORMER CITIZENS GAS WORKS MANUFACTURED GAS PLANT SITE  
CARROLL GARDENS/PUBLIC PLACE  
BOROUGH OF BROOKLYN, KINGS COUNTY, NEW YORK  
SITE REMEDIATION

**BULKHEAD BARRIER WALL DETAILS**

Arcadis Project No. 80036728.0001.00003	<b>S-510</b>
Date AUGUST 2021	
Arcadis One Lincoln Center 110 West Fayette Street, Suite 300 Syracuse, NY 13202 Tel. 315.446.9120	

**Hydraulic Relief System Design: Background and Timeline  
Former Citizens Gas Works Manufactured Gas Plant Site  
Borough of Brooklyn, Kings County, New York  
NYSDEC Site Nos. C224012 and C224012B**

The primary purpose of the passive hydraulic relief system is to prevent structural damage to or excessive deflection of the bulkhead barrier wall system due to increases in groundwater mounding caused by future activities and conditions unrelated to the Citizens remediation project (e.g., Site development, climate change, etc.). The hydraulic relief system was first included in the *95% Remedial Design Report* (95% RD), which was submitted to NYSDEC (with copy to USEPA) on January 27, 2017. As indicated in Section 3.3.2.1 of that document, the system generally comprised nominal 6-inch diameter perforated high-density polyethylene (HDPE) piping located immediately behind the bulkhead at an average invert elevation of 6.12 feet NAVD88 and five precast concrete manholes. The manholes included internal environmental hoods over the openings for the outlet pipes to help control sheens/floatables. On August 10, 2017, representatives of NYSDEC and USEPA met to discuss the 95% RD. In a follow-up e-mail dated August 14, 2017, USEPA indicated that it did not have any comments on the 95% RD. The *100% Remedial Design Report* (100% RD) was submitted to NYSDEC (with copy to USEPA) on November 30, 2017 and included the same hydraulic relief system design that had been previously included in the 95% RD. The 100% RD was approved by NYSDEC on January 2, 2018.

In July 2019, following the demobilization of Ferrara Brothers Building Materials Corporation, National Grid mobilized to the Site to begin the remediation work. In September 2019, USEPA voiced comments regarding the: (1) elevation of the hydraulic relief piping and Site-wide groundwater mounding; and (2) treatment capabilities of the hydraulic relief manholes. National Grid and USEPA participated in a conference call on October 8, 2019 to discuss USEPA's comments on the hydraulic relief system. In response to the comments voiced by USEPA on that call, National Grid revised the hydraulic relief system design by: (1) lowering the piping by approximately 4 feet (from an average invert elevation of 6.12 feet NAVD88 to an average invert elevation of approximately 2.00 feet NAVD88) in the central portion of the bulkhead barrier wall where the greatest model-predicted groundwater mounding will occur, as well as the remainder of Parcel II where the cantilevered bulkhead barrier wall is being installed; and (2) adding internal vortex-type hydrodynamic separators (water quality/treatment units) to the manholes to more closely align with the function of the oil-water separators being installed at the Fulton MGP site. An additional (sixth) manhole was also added south of the existing gas transmission tunnel shaft on Parcel II of the Site to accommodate the lower piping in that area, which could not be tied into the existing manhole (manhole MH-3) due to the configuration of the hydrodynamic separator within the manhole.

National Grid met with USEPA on November 18, 2019 to go over the proposed changes to the hydraulic relief system and, on December 3, 2019, the revised design drawings and product information/specifications for the proposed hydrodynamic separators (First Defense HC Stormwater Treatment Device, by Hydro International, Ltd.) were transmitted electronically to USEPA for review. On December 9, 2019, National Grid received a response e-mail back from USEPA indicating that USEPA had "concluded that these proposed changes are along the lines that were discussed during our recent meeting and they fully address EPA's comments on the matter." USEPA went on to indicate that it had "no further comments on the engineering drawings." The changes to the hydraulic relief system design were subsequently reflected in the January 13, 2020 Permit Equivalency Application Package for the bulkhead barrier wall, which was approved by USEPA on January 22, 2020, and in *Remedial Design Addendum No. 4*, which was submitted to NYSDEC (with copy to USEPA) on February 23, 2020.